
Form 51-10M-7-20-CroMac

Map No. K-43 Sec. 5 Twp. 22 R. 4

Well No. 1 Bothwell Farm

Elmaradale Oil Company

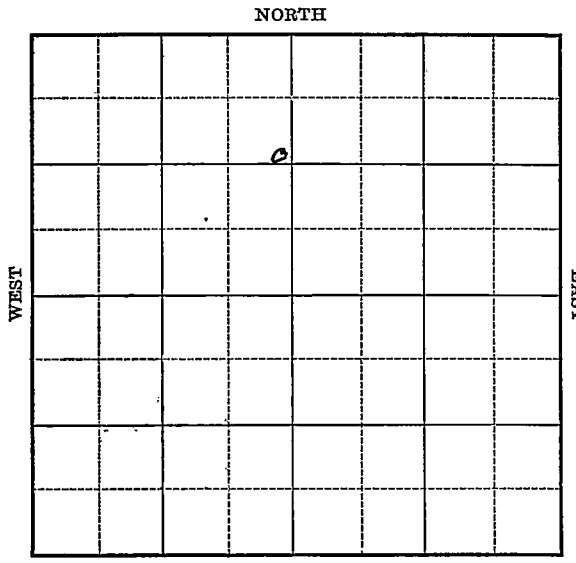

23

FIRST SAMPLE

Location

Drilling Remarks: COMPLETED

Rig Up

Drilling Remarks:

RECORD		PRODUCTION	
Cased	in. ft.	1st 24 hrs. Nat.	
Sand		1st 24 hrs. after shot	
Gas		Gas	cu. ft.
Oil		Dry Hole	
Total Depth		Abandoned	

Form 252A—6M-3-20-CroMac

Map No. K. 23 Sec. 5 Twp. 22 R. 4

Well No. 1 Bothwell Farm


Elmerdale Dev. Company

1120 Ft. from N. Line

_____ Ft. from S. Line

700 Ft. srom E. Line

_____ Ft from W. Line

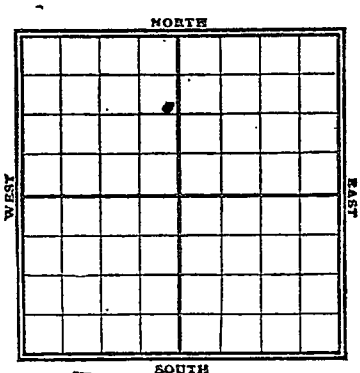

TEST REPORT

Date	REPORT
1920	
6/23	Rig up
8/31	Spud COMPLETED
9/13	drlg 1150
9-20	" 2058'
27	8" Collapsed 2287
10/1	2495 - 99 - 100 bbls
	Oil 50 bbl water

Form 26—1M—4-19—Mid-West

Map No. K23 Sec. 5 Twp. 22 R. 4

Well No. 1 Bothwell

Elmendale Oil Company

Contractor

SECTION PLAT



1120 Ft. from N. Line

Ft. from S. Line

200 Ft. from E. Line

Ft. from W. Line

Location

Rig up

Drilling and Remarks:

RECORD

Cased in., ft.

Sand

Gas

Oil

Total Depth

PRODUCTION

1st 24 hrs. Nat.

1st 24 hrs. after shot

Gas Cu. Ft.

Dry Hole

Abandoned

Date 8/23 1920

Pyle Scout

Form 26—1M—4-19—Mid-West


Map No. K 23 Sec. 5 Twp. 22 R. 4

Well No. 1 Bothwell

Emerdale Oil Company

Contractor

SECTION PLAT

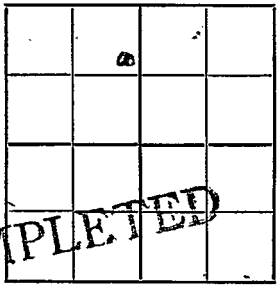

1120 Ft. from N. Line

Ft. from S. Line

200 Ft. from E. Line

Ft. from W. Line

COMPLETED

Location

Rig up

Drilling and Remarks:

100 bbls Oil

50 bbls water

RECORD

Cased in., ft.

Sand 2495-99

Gas

Oil

Total Depth

PRODUCTION

1st 24 hrs. Nat.

1st 24 hrs. after shot

Gas Cu. Ft.

Dry Hole

Abandoned

Date

10/18 1920

Pyle Scout