
Form 51-10M-7-20-CroMac

Map No. K 23 Sec. 5 Twp. 22 R. 4

Well No. 2 Bothwell Farm

Elmendale Oil Company

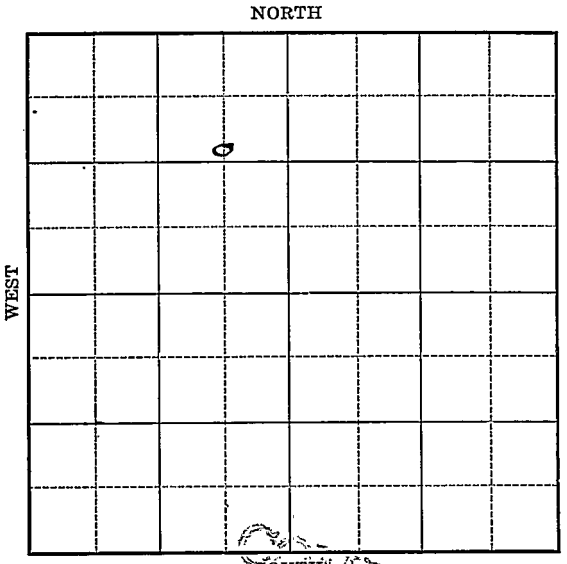

3

Location _____

Drilling Remarks:

Rig Up _____

Drilling Remarks:

RECORD

Cased _____ in. _____ ft.

Sand _____

Gas _____

Oil _____

Total Depth _____

PRODUCTION

1st 24 hrs. Nat. _____

1st 24 hrs. after shot _____

Gas _____ cu. ft.

Dry Hole _____


Abandoned _____

Form 252A—6M-3-20-CroMac

Map No. K 23 Sec. 5 Twp. 22 R. 4

Well No. 2 Bothwell Farm

Elmendale Oil Company

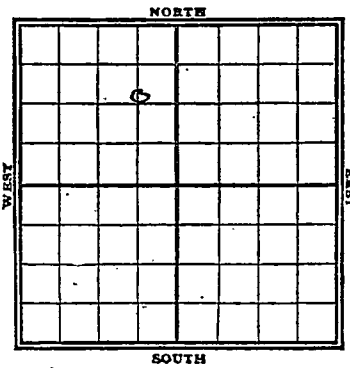

1120 Ft. from N. Line

_____ Ft. from S. Line

660 Ft. srom E. Line

_____ Ft from W. Line

Date	REPORT
~~1920~~	REPORT
9/20	Spud
27	Dly 1030'
1921	COMPLETED
1/23	D. a C. 2515'

Form 26—1M—4-19—Mid-West


Map No. K23 Sec. 5 Twp. 22 R. 4

Well No. 2 Bothwell

Elmendale Oil Company

Contractor

SECTION PLAT

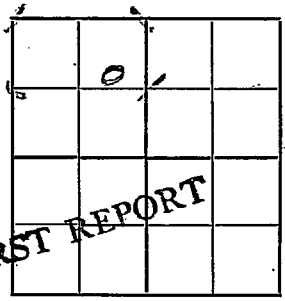

1120 Ft. from N. Line

Ft. from S. Line

660 Ft. from E. Line

Ft. from W. Line

Location

Rig up

Drilling and Remarks:

Spud

RECORD

Cased in., ft.

Sand

Gas

Oil

Total Depth

PRODUCTION

1st 24 hrs. Nat.

1st 24 hrs. after shot

Gas Cu. Ft.

Dry Hole

Abandoned

Date

9/20 1920

Pyle Scout

Form 26—1M—4-19—Mid-West


Map No. T 23 Sec. 5 Twp. 22 R. 4

Well No. 2 Bothwell

Edmondale Ord Company

Contractor

SECTION PLAT

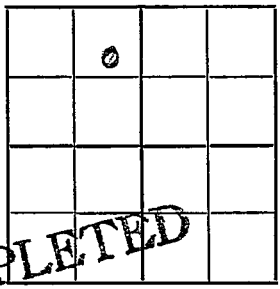

1120 Ft. from N. Line

Ft. from S. Line

660 Ft. from E. Line

Ft. from W. Line

COMPLETED

Location

Rig up

Drilling and Remarks:

RECORD

Cased in., ft.

Sand

Gas

Oil

Total Depth

PRODUCTION

1st 24 hrs. Nat.

1st 24 hrs. after shot

Gas /Cu. Ft.

Dry Hole 2515

Abandoned

Date

1/23 1921

Scout

FORM 26 250 BKS. 4-26 WESTERN


MAP NO. _____ SEC. 5 TWP. 28S R. 4E

WELL NO. 2 Bothwell

Elmendale Oil COMPANY

_____ CONTRACTOR

SECTION PLAT

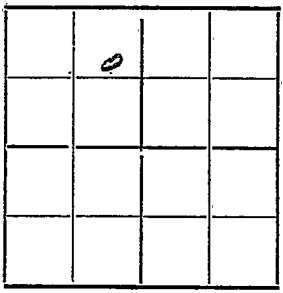

_____ FT. FROM N. LINE

_____ FT. FROM S. LINE

_____ FT. FROM E. LINE

_____ FT. FROM W. LINE

LOCATION _____

RIG UP _____

DRILLING AND REMARKS:

2515

RECORD

CASED _____ IN., _____ FT.

SAND _____

GAS _____

OIL _____

TOTAL DEPTH 2250

PRODUCTION

1ST 24 HRS. NAT. _____

1ST 24 HRS. AFTER SHOT _____

GAS _____ CU. FT.

DRY HOLE 2

ABANDONED _____

DATE Nov 15 1920

_____ SCOUT