



Map No. \_\_\_\_\_ Sec. 5 Twp. 22 R. 10

Well No. 1 Pyley Farm \_\_\_\_\_  
Empire Company \_\_\_\_\_

NORTH

200 Ft. from N. Line


\_\_\_\_\_ Ft. from S. Line

\_\_\_\_\_ Ft. from E. Line

200 Ft. from W. Line

WEST

EAST

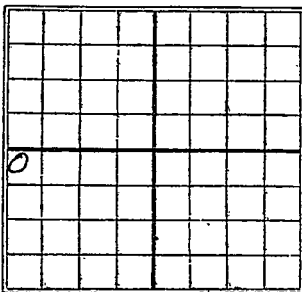

SOUTH

Date

REPORT

1972

12/30

D. & A. 2460'

Map No. K71 Sec. 5 Twp. 22 R. 10

Well No. 1 Pilsbury  
Empire Company

Contractor \_\_\_\_\_

SECTION PLAT

200 Ft. from N. Line  
 \_\_\_\_\_ Ft. from S. Line  
 \_\_\_\_\_ Ft. from E. Line  
200 Ft. from W. Line


**TEST REPORT**  
 - - - - -

Location \_\_\_\_\_

Rig up \_\_\_\_\_

Drilling and Remarks:

sand 2305-29  
T.D. 2358,  
pumped 30 ffls  
plug back to  
2329, shot 80  
etc water came  
in after shot,  
later day to

RECORD

Cased \_\_\_\_\_ in., \_\_\_\_\_ ft.  
 Sand \_\_\_\_\_  
 Gas \_\_\_\_\_  
 Oil \_\_\_\_\_  
 Total Depth \_\_\_\_\_

PRODUCTION

1st 24 hrs. Nat. \_\_\_\_\_  
 1st 24 hrs. after shot \_\_\_\_\_  
 Gas \_\_\_\_\_ Cu. Ft.  
 Dry Hole \_\_\_\_\_  
 Abandoned \_\_\_\_\_

Date 2460 and abandoned on account of fishing job.

12/30/22 191 \_\_\_\_\_ Scout