


Greenwood
Map No. *Kansas* Sec. *5* Twp. *22* R. *12* ✓
Well No. *1 Gardner* Farm
Phillips Pet Company

NORTH

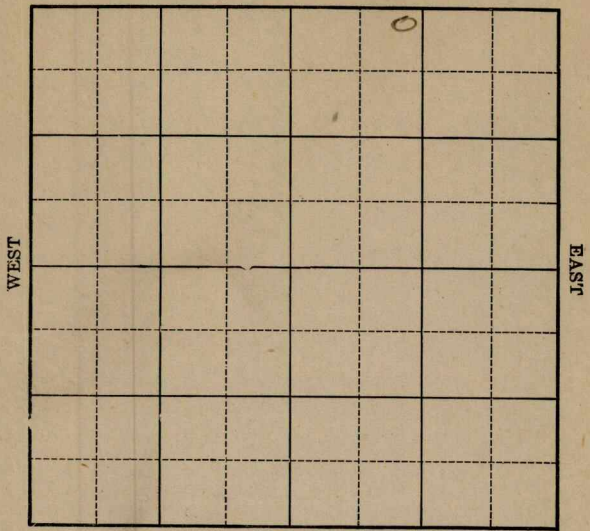

SOUTH

Location _____

Drilling Remarks _____

Rig Up _____

Drilling Remarks _____

RECORD

Cased _____ in. _____ ft.
Sand _____
Gas _____
Oil _____
Total Depth _____

PRODUCTION

1st 24 hrs. Nat. _____
1st 24 hrs. after shot _____
Gas _____ cu. ft.
Dry Hole _____
Abandoned _____

Sherwood Co

Map No. 21 KANSAS Sec. 5 Twp. 22 R. 12

Well No. Sanderson

Phillips Petroleum Co Company

Contractor

COMPLETED

SECTION PLAT

300 Ft. from N. Line
Ft. from S. Line
Ft. from E. Line
1020 Ft. from W. Line

		o	

Location -----

Rig up -----

Drilling and Remarks:

oil 1883-1910'

90/30 bls.

RECORD

Cased _____ in., _____ ft.

Sand 1848-1910'

Gas -----

Oil -----

Total Depth 1910'

PRODUCTION

1st 24 hrs. Nat. -----

1st 24 hrs. after shot -----

Gas ----- Cu. Ft.

Dry Hole -----

Abandoned -----

Date

JAN 27 1926

192

CHAS. L. SHERWOOD
Scout

Sherwood Co

Map No. **KANSAS** Sec. **5** Twp. **22** R. **12**

Well No. *1* *Darden*

Phillips Petroleum Co Company

Contractor

SECTION PLAT

300

Ft. from N. Line

Ft. from S. Line

Ft. from E. Line

1070

Ft. from W. Line

		<i>0</i>	

FIRST REPORTS

Location -----

Rig up -----

Drilling and Remarks:

Blow Pipe

RECORD

Cased ----- in., ----- ft.

Sand -----

Gas -----

Oil -----

Total Depth -----

PRODUCTION

1st 24 hrs. Nat. -----

1st 24 hrs. after shot -----

Gas ----- Cu. Ft.

Dry Hole -----

Abandoned -----

Date

DEC 23 1925

CHAS. L. SHERWOOD

192

Scout