


SECTION 5 TOWNSHIP 22 RANGE 12 E

WELL NO. #1 Kipfer

COMPANY Harold Ellis

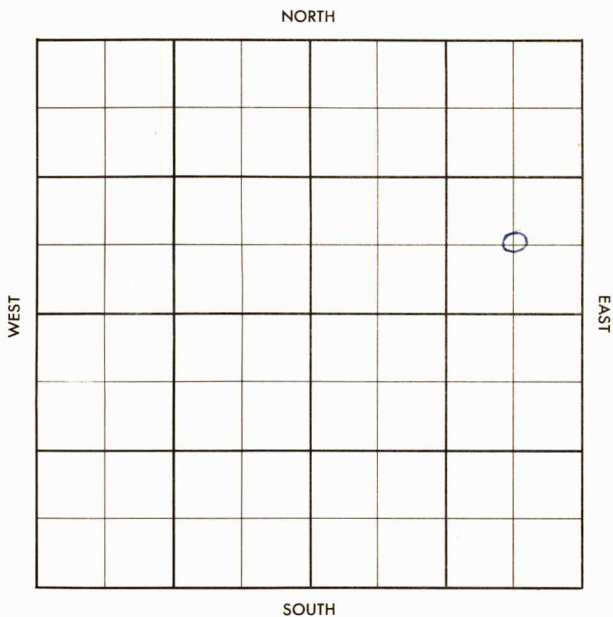

Greenwood

KANSAS

SEC.	TWP.	R.
5	22	12E

WELL NO.

#1 Kipfer

FARM

COMPANY

Harold Ellis

CONTRACTOR

Geneva

Frankhouser


_____ Ft. from N. Line

_____ Ft. from S. Line

_____ Ft. from E. Line

_____ Ft. from W. Line

C SE NE

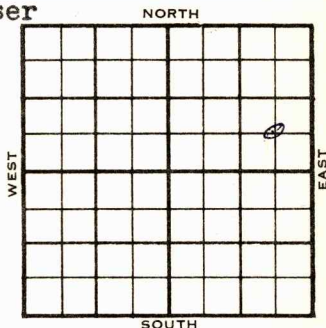

1955	ELEVATION	REPORT
11-23	Comm. 11-19-55 8" @ 105/50 Drlg. 1260	
<u>1956</u>		
1-5	4½" @ 1884 DD 1896 FU 600' oil, 400' wtr. 16 hrs. Frac, Comp. 15 bopd, 2 bw. Bart 1885' TD 1885 ' 1896'	

COMPLETED

County Greenwood Elev. _____
 Sec. 5 Twp. 22 Rge. 12E
 Company Harold Ellis
 Farm Name Kipfer No. 1

TOPS	DEPTH	LOG	DATUM	Loc. in Sec.
Anh.				C SE NE
TP.				
H.				
Tr.				
Dg.				
Bl.				
L.				Geol. _____
K.C.				Contr. _____
B.K.C.				
Ce.				
C.				
M.				Pool _____
K. <u>Bart</u>	<u>1885</u>			<u>Fankhouser</u>
Mz.				
Ma.				
V.				
S.				
S.				
A.				
R.				
PE.				
G.				COMPLETE
TD.	<u>1885</u>			

Date Comm. 11-19-55 JAN 5 1956
8" @ 105/50 4 1/2" @ 1884 DD 1896
FU 600' oil 400' wtr. 16 hr.
frac Comp. 15 bopd 2 bw

Co.
Lse.
No.
Sec.
T.
R.

County Greenwood Elev. _____
 Sec. 5 Twp. 22 Rge. 12E
 Company Harold Ellis
 FarmName Kipfer No. 1

TOPS	DEPTH	LOG	DATUM	Loc. in Sec.
Anh.				C SE NE
TP.				
H.				
Tr.				
Dg.				
BL.				
L.				Geol. _____
K.C.				Contr. _____
B.K.C.				
Ce.				Geneva
C.				
M.				Pool _____
M.				Frankhouser
K.				
Mz.				
Me.				
V.				
S.				
S.				
A.				
R.				
PE.				FIRST REPORT
G.				
T.D.				

Date Comm. 11-19-55
8" @ 105/50 drlg. 1260

Co.
Lse.
No.
Sec.
T.
R.