

Map No. \_\_\_\_\_ Sec. 5 Twp. 22 R. 13Well No. 9 m waves Farm \_\_\_\_\_Barnes & Co. Company

NORTH

WEST

EAST



SOUTH

Location 8/26

Rig Up \_\_\_\_\_

Drilling Remarks

Drilling Remarks

9/30 - Pipe on ground.10/7 - Inc 10/24 = 10/2110/28 - 500'720 - 11/4 = 11/11700 - 11/18900 - 11/251000 - 12/21400 - 12/9Dry

## RECORD

## PRODUCTION

Cased \_\_\_\_\_ in. \_\_\_\_\_ Ft.

1st 24 hrs. Nat. \_\_\_\_\_

Sand \_\_\_\_\_

1st 24 hrs. after shot \_\_\_\_\_

Gas \_\_\_\_\_

Gas \_\_\_\_\_ Cu. Ft.

Oil \_\_\_\_\_


Dry Hole \_\_\_\_\_

Total Depth \_\_\_\_\_

Abandoned 1900

Map No. \_\_\_\_\_ Sec. 5 Twp. 22 R. 13  
 Well No. F.M. Weaver Farm \_\_\_\_\_  
Barwicklow & Son Company

NORTH

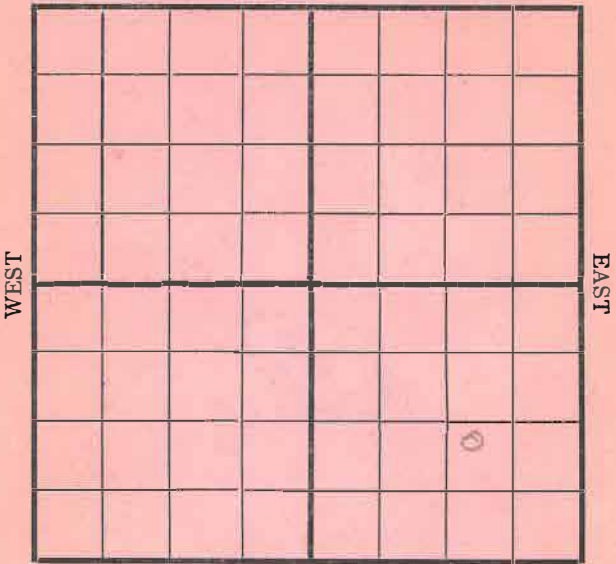

SOUTH

Location ✓  
 Rig Up \_\_\_\_\_  
 Drilling and remarks \_\_\_\_\_

**RECORD**

Cased \_\_\_\_\_ in. \_\_\_\_\_ Ft.  
 Sand \_\_\_\_\_  
 Gas \_\_\_\_\_  
 Oil \_\_\_\_\_  
 Total Depth \_\_\_\_\_

**PRODUCTION**

1st 24 hrs. Nat. \_\_\_\_\_  
 1st 24 hrs. after shot \_\_\_\_\_  
 Gas \_\_\_\_\_ Cu. Ft.  
 Dry Hole \_\_\_\_\_  
 Abandoned \_\_\_\_\_

Date 8/26, 1916 E. H. West Scout

Map No. Sec. 5 Twp. 22 R. 13Well No. 1 Weaver Farm  
Barricklow & Donley Company

NORTH



SOUTH

Location  
Rig Up  
Drilling and remarks

**RECORD**

Cased \_\_\_\_\_ in. \_\_\_\_\_ Ft.

Sand \_\_\_\_\_

Gas \_\_\_\_\_

Oil \_\_\_\_\_

Total Depth \_\_\_\_\_

**PRODUCTION**

1st 24 hrs. Nat. \_\_\_\_\_

1st 24 hrs. after shot \_\_\_\_\_


Gas \_\_\_\_\_ Cu. Ft.

Dry Hole \_\_\_\_\_

Abandoned \_\_\_\_\_

Date 9/2, 1916, Green ScoutMap No. Sec. 5 Twp. 22 R. 13Well No. 1 J.M. Weaver Farm  
Barricklow & Donley Company

NORTH

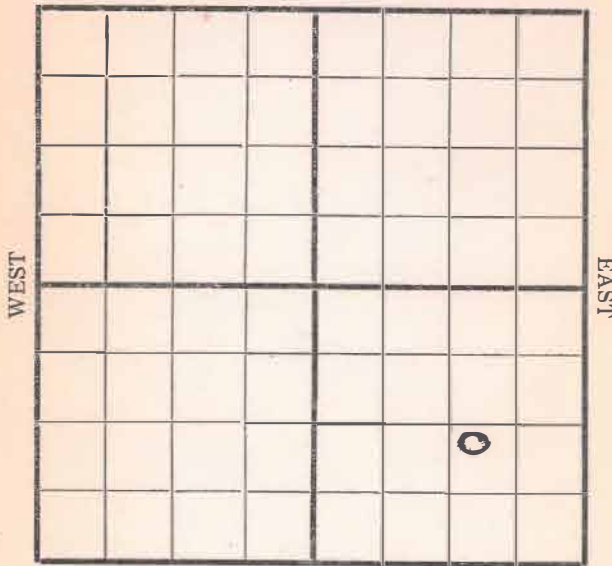

SOUTH

Location  
Rig Up  
Drilling and remarks

**RECORD**

Cased \_\_\_\_\_ in. \_\_\_\_\_ Ft.

Sand \_\_\_\_\_

Gas \_\_\_\_\_

Oil \_\_\_\_\_

Total Depth \_\_\_\_\_

**PRODUCTION**

1st 24 hrs. Nat. \_\_\_\_\_

1st 24 hrs. after shot \_\_\_\_\_


Gas \_\_\_\_\_ Cu. Ft.

Dry Hole \_\_\_\_\_

Abandoned \_\_\_\_\_

Date 9, 1916, Green ScoutMap No. Sec. 5 Twp. 22 R. 13Well No. 1 Weaver Farm  
Barricklow & Donley Company

NORTH

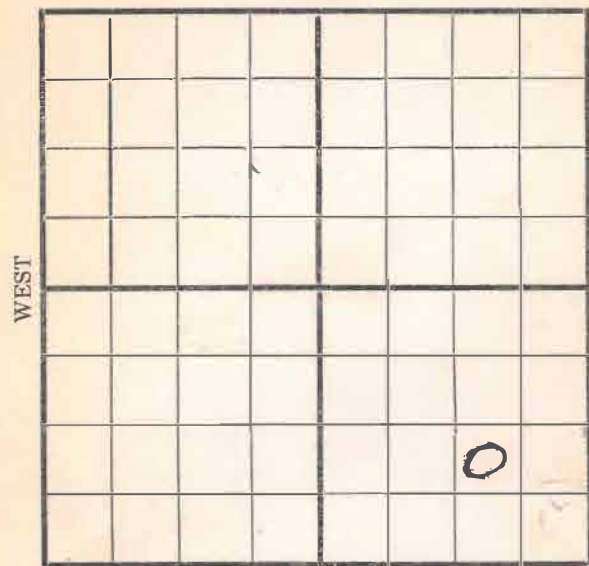

SOUTH

Location  
Rig Up  
Drilling and remarks

**RECORD**

Cased \_\_\_\_\_ in. \_\_\_\_\_ Ft.

Sand \_\_\_\_\_

Gas \_\_\_\_\_

Oil \_\_\_\_\_

Total Depth \_\_\_\_\_

**PRODUCTION**

1st 24 hrs. Nat. \_\_\_\_\_

1st 24 hrs. after shot \_\_\_\_\_


Gas \_\_\_\_\_ Cu. Ft.

Dry Hole \_\_\_\_\_

Abandoned \_\_\_\_\_

Date 9/9, 1916, Green ScoutMap No. Sec. 5 Twp. 22 R. 13Well No. 1 Weaver Farm  
Barricklow & Donley Company

NORTH

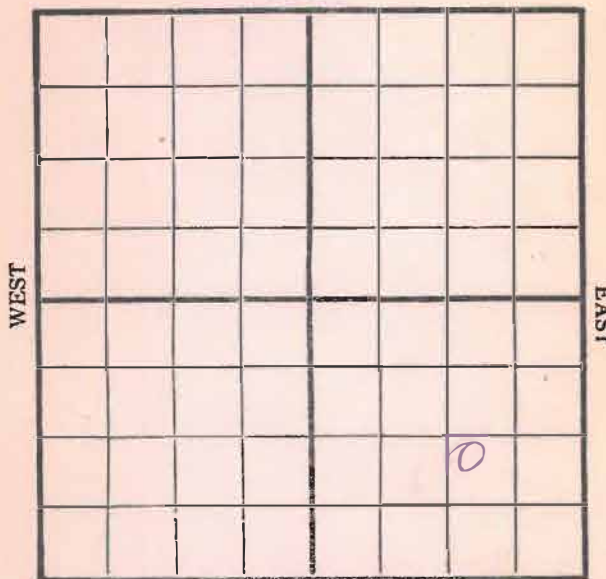

SOUTH

Location  
Rig Up  
Drilling and remarks

**RECORD**

Cased \_\_\_\_\_ in. \_\_\_\_\_ Ft.

Sand \_\_\_\_\_

Gas \_\_\_\_\_

Oil \_\_\_\_\_

Total Depth \_\_\_\_\_

**PRODUCTION**

1st 24 hrs. Nat. \_\_\_\_\_

First 24 hrs. after shot \_\_\_\_\_


Gas \_\_\_\_\_ Cu. Ft.

Dry Hole \_\_\_\_\_

Abandoned \_\_\_\_\_

Date 9/16, 1916, Green ScoutMap No. Sec. 5 Twp. 22 R. 13Well No. 1 Weaver Farm  
Barricklow & Donley Company

NORTH

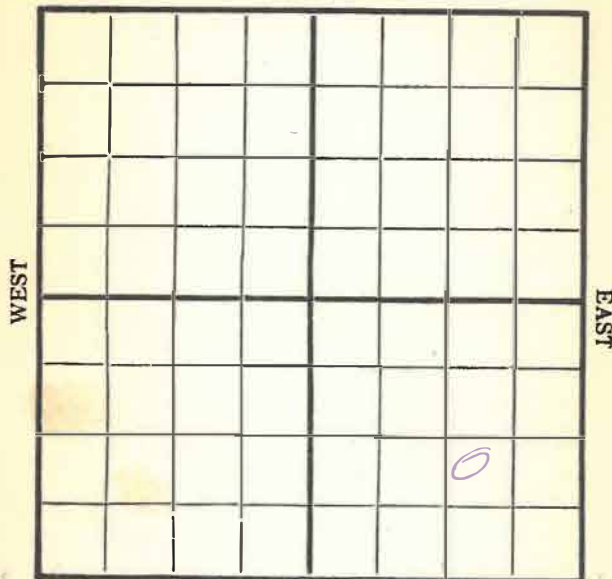

SOUTH

Location  
Rig Up  
Drilling and remarks

**RECORD**

Cased \_\_\_\_\_ in. \_\_\_\_\_ Ft.

Sand \_\_\_\_\_

Gas \_\_\_\_\_

Oil \_\_\_\_\_

Total Depth \_\_\_\_\_

**PRODUCTION**

1st 24 hrs. Nat. \_\_\_\_\_

First 24 hrs. after shot \_\_\_\_\_


Gas \_\_\_\_\_ Cu. Ft.

Dry Hole \_\_\_\_\_

Abandoned \_\_\_\_\_

Date 9/23, 1916, Green ScoutMap No. Sec. 5 Twp. 22 R. 13Well No. 1 Weaver Farm  
Barricklow & Donley Company

NORTH

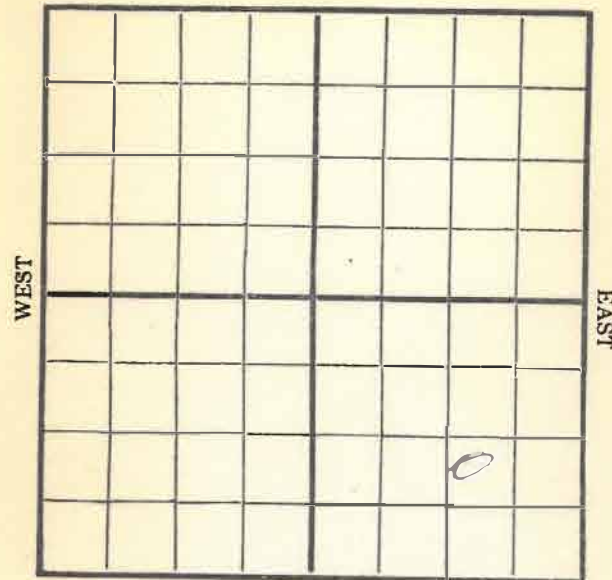

SOUTH

Location  
Rig Up  
Drilling and remarks

**RECORD**

Cased \_\_\_\_\_ in. \_\_\_\_\_ Ft.

Sand \_\_\_\_\_

Gas \_\_\_\_\_

Oil \_\_\_\_\_

Total Depth \_\_\_\_\_

**PRODUCTION**

1st 24 hrs. Nat. \_\_\_\_\_

1st 24 hrs. after shot \_\_\_\_\_


Gas \_\_\_\_\_ Cu. Ft.

Dry Hole \_\_\_\_\_

Abandoned \_\_\_\_\_

Date 9/30, 1916, Green Scout

Map No. Greenwood Sec. 5 Twp. 22 R. 13  
 Well No. 1 Weaver Farm  
Barricklow & Donley Company

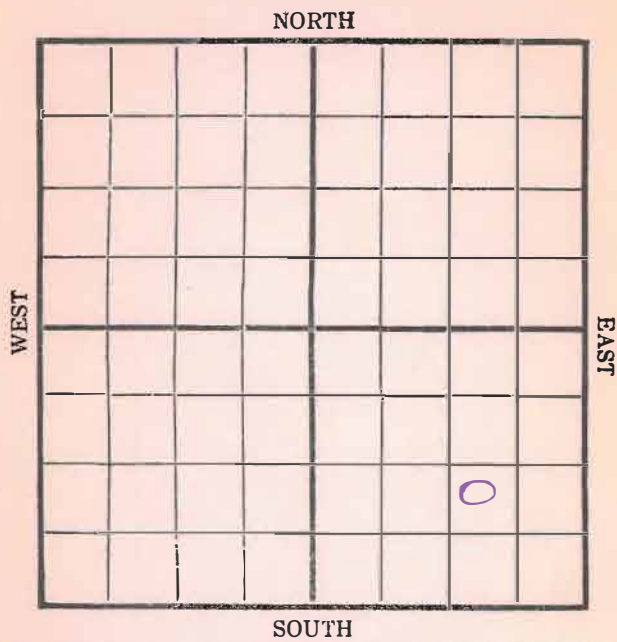


Location ☒ ✓  
 Rig Up \_\_\_\_\_  
 Drilling and remarks \_\_\_\_\_

**RECORD**  
 Cased \_\_\_\_\_ in. \_\_\_\_\_ Ft.  
 Sand \_\_\_\_\_  
 Gas \_\_\_\_\_  
 Oil \_\_\_\_\_  
 Total Depth \_\_\_\_\_

**PRODUCTION**  
 1st 24 hrs. Nat. \_\_\_\_\_  
 First 24 hrs. after shot \_\_\_\_\_  
 Gas \_\_\_\_\_ Cu. Ft.  
 Dry Hole \_\_\_\_\_  
 Abandoned \_\_\_\_\_

Date 10/14, 1916, E. H. WEST Scout

Map No. Greenwood Sec. 5 Twp. 22 R. 13  
 Well No. 1 Weaver Farm  
Barricklow & Donley Company

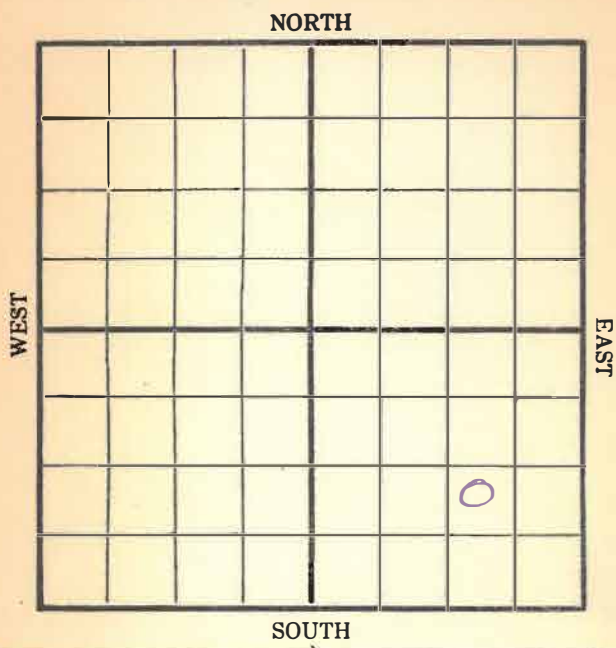


Location ☒ ✓  
 Rig Up \_\_\_\_\_  
 Drilling and remarks \_\_\_\_\_

**RECORD**  
 Cased \_\_\_\_\_ in. \_\_\_\_\_ Ft.  
 Sand \_\_\_\_\_  
 Gas \_\_\_\_\_  
 Oil \_\_\_\_\_  
 Total Depth \_\_\_\_\_

**PRODUCTION**  
 1st 24 hrs. Nat. \_\_\_\_\_  
 1st 24 hrs. after shot \_\_\_\_\_  
 Gas \_\_\_\_\_ Cu. Ft.  
 Dry Hole \_\_\_\_\_  
 Abandoned \_\_\_\_\_

Date 10/14, 1916, E. H. WEST Scout

Map No. Greenwood Sec. 5 Twp. 22 R. 13  
 Well No. 1 Weaver Farm  
Barricklow & Donley Company

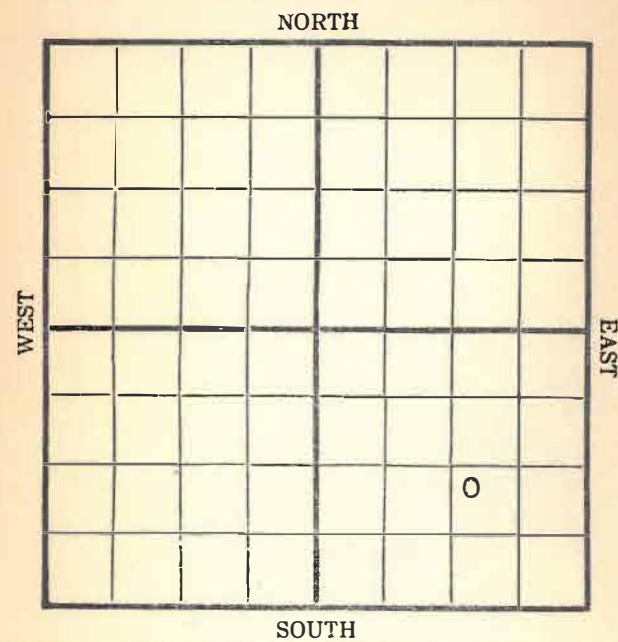


Location ☒ ✓  
 Rig Up \_\_\_\_\_  
 Drilling and remarks \_\_\_\_\_

**RECORD**  
 Cased \_\_\_\_\_ in. \_\_\_\_\_ Ft.  
 Sand \_\_\_\_\_  
 Gas \_\_\_\_\_  
 Oil \_\_\_\_\_  
 Total Depth \_\_\_\_\_

**PRODUCTION**  
 1st 24 hrs. Nat. \_\_\_\_\_  
 First 24 hrs. after shot \_\_\_\_\_  
 Gas \_\_\_\_\_ Cu. Ft.  
 Dry Hole \_\_\_\_\_  
 Abandoned \_\_\_\_\_

Date OCT 21 1916, 1916, E. H. WEST Scout

Map No. Greenwood Sec. 5 Twp. 22 R. 13  
 Well No. 1 Weaver Farm  
Barricklow & Donley Company

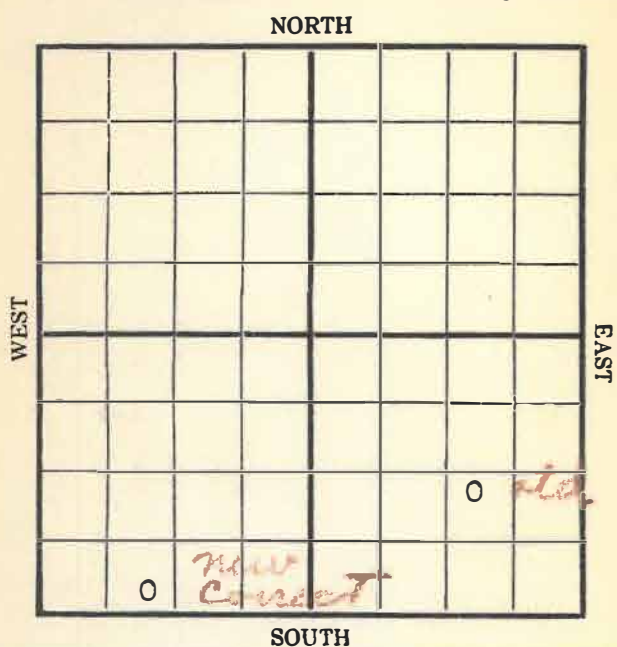


Location \_\_\_\_\_  
 Rig Up Star Mch  
 Drilling and remarks / 500

**RECORD**  
 Cased \_\_\_\_\_ in. \_\_\_\_\_ Ft.  
 Sand \_\_\_\_\_  
 Gas \_\_\_\_\_  
 Oil \_\_\_\_\_  
 Total Depth \_\_\_\_\_

**PRODUCTION**  
 1st 24 hrs. Nat. \_\_\_\_\_  
 1st 24 hrs. after shot \_\_\_\_\_  
 Gas \_\_\_\_\_ Cu. Ft.  
 Dry Hole \_\_\_\_\_  
 Abandoned \_\_\_\_\_

Date OCT 28 1916, 1916, E. H. WEST Scout

Map No. Greenwood Sec. 5 Twp. 22 R. 13  
 Well No. 1 Weaver Farm  
Barricklow & Donley Company

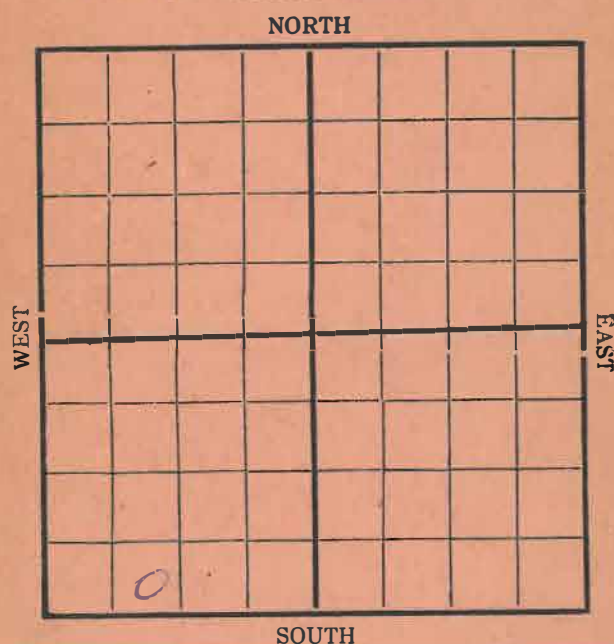


Location \_\_\_\_\_  
 Rig Up \_\_\_\_\_  
 Drilling and remarks 720

**RECORD**  
 Cased \_\_\_\_\_ in. \_\_\_\_\_ Ft.  
 Sand \_\_\_\_\_  
 Gas \_\_\_\_\_  
 Oil \_\_\_\_\_  
 Total Depth \_\_\_\_\_

**PRODUCTION**  
 1st 24 hrs. Nat. \_\_\_\_\_  
 1st 24 hrs. after shot \_\_\_\_\_  
 Gas \_\_\_\_\_ Cu. Ft.  
 Dry Hole \_\_\_\_\_  
 Abandoned \_\_\_\_\_

Date 11/4, 1916, E. H. WEST Scout

Map No. \_\_\_\_\_ Sec. 5 Twp. 22 R. 13  
 Well No. 9 M. Weaver Farm \_\_\_\_\_  
Barricklow & Donley Company

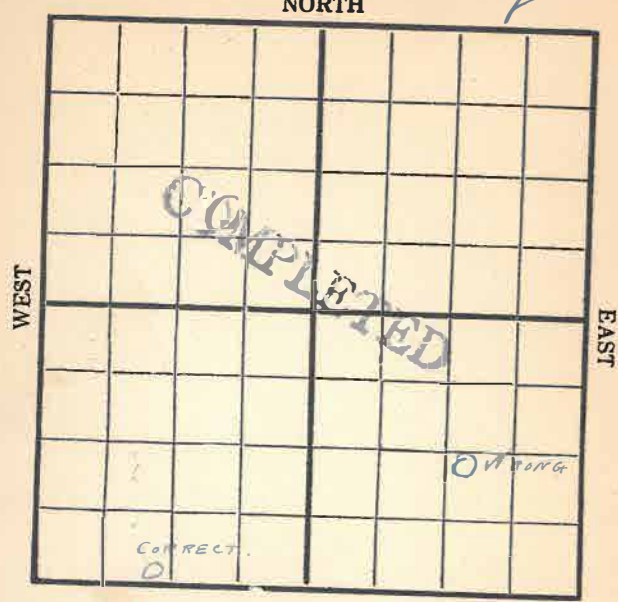

Location 8/26 Rig Up \_\_\_\_\_

Drilling Remarks \_\_\_\_\_

9/30 - Cased on ground.

10/7 - 200 10/10 - 10/21

10/28 - 500

720 - 11/4 - 11/11

700 - 11/18

900 - 11/25

1000 - 12/2

1400 - 12/9

Dry


## RECORD

Cased \_\_\_\_\_ in. \_\_\_\_\_ Ft.  
 Sand \_\_\_\_\_  
 Gas \_\_\_\_\_  
 Oil \_\_\_\_\_  
 Total Depth \_\_\_\_\_

## PRODUCTION

1st 24 hrs. Nat. \_\_\_\_\_  
 1st 24 hrs. after shot \_\_\_\_\_  
 Gas \_\_\_\_\_ Cu. Ft.  
 Dry Hole \_\_\_\_\_  
 Abandoned 1400

Map No. \_\_\_\_\_ Sec. 5 Twp. 22 R. 13  
 Well No. 1 Weaver Farm \_\_\_\_\_  
Barricklow & Donley Company

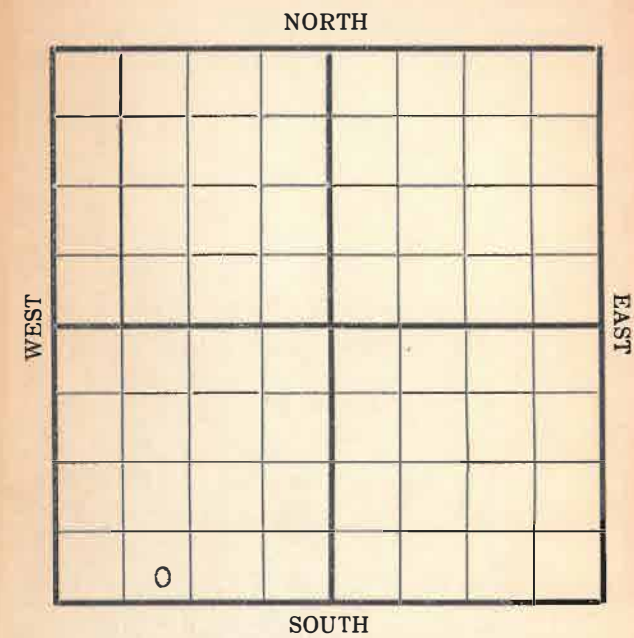

Location \_\_\_\_\_  
 Rig Up \_\_\_\_\_  
 Drilling and remarks \_\_\_\_\_

UR to 900

## RECORD

Cased \_\_\_\_\_ in. \_\_\_\_\_ Ft.  
 Sand \_\_\_\_\_  
 Gas \_\_\_\_\_  
 Oil \_\_\_\_\_  
 Total Depth \_\_\_\_\_


## PRODUCTION

1st 24 hrs. Nat. \_\_\_\_\_  
 1st 24 hrs. after shot \_\_\_\_\_  
 Gas \_\_\_\_\_ Cu. Ft.  
 Dry Hole \_\_\_\_\_  
 Abandoned \_\_\_\_\_

Date

NOV 25 1916

Map No. \_\_\_\_\_ Sec. 5 Twp. 22 R. 13  
 Well No. 1 Weaver Farm \_\_\_\_\_  
Barricklow & Donley Company

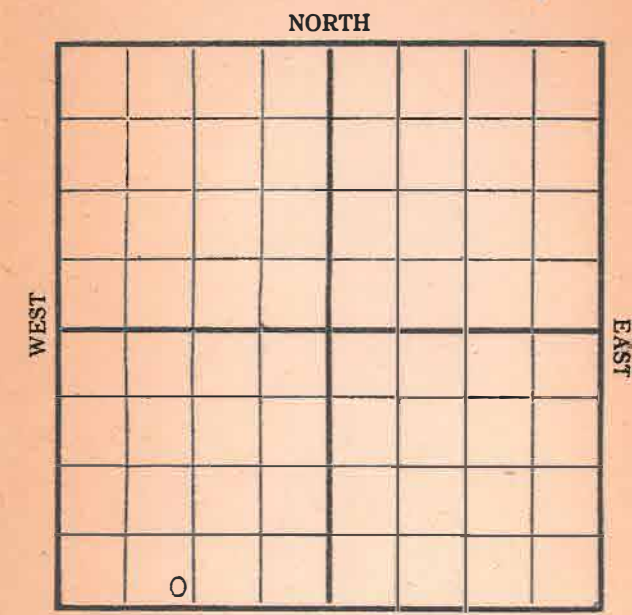

Location \_\_\_\_\_  
 Rig Up \_\_\_\_\_  
 Drilling and remarks \_\_\_\_\_

700

## RECORD

Cased \_\_\_\_\_ in. \_\_\_\_\_ Ft.  
 Sand \_\_\_\_\_  
 Gas \_\_\_\_\_  
 Oil \_\_\_\_\_  
 Total Depth \_\_\_\_\_

## PRODUCTION

1st 24 hrs. Nat. \_\_\_\_\_  
 1st 24 hrs. after shot \_\_\_\_\_  
 Gas \_\_\_\_\_ Cu. Ft.  
 Dry Hole \_\_\_\_\_  
 Abandoned \_\_\_\_\_


Date

NOV 11 1916

E. H. WEST

Scout

Map No. \_\_\_\_\_ Sec. 5 Twp. 22 R. 13  
 Well No. 1 Weaver Farm \_\_\_\_\_  
Barricklow & Donley Company

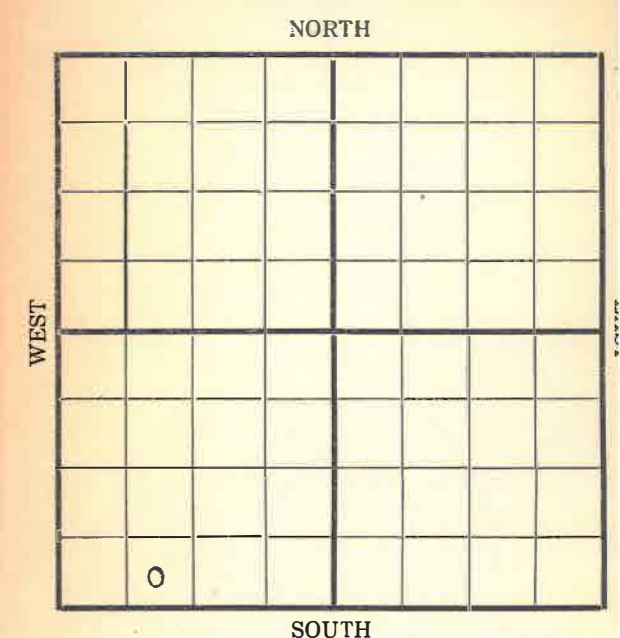

Location \_\_\_\_\_  
 Rig Up \_\_\_\_\_  
 Drilling and remarks \_\_\_\_\_

S.D -700 casing

## RECORD

Cased \_\_\_\_\_ in. \_\_\_\_\_  
 Sand \_\_\_\_\_  
 Gas \_\_\_\_\_  
 Oil \_\_\_\_\_  
 Total Depth \_\_\_\_\_

## PRODUCTION

1st 24 hrs. Nat. \_\_\_\_\_  
 1st 24 hrs. after shot \_\_\_\_\_  
 Gas \_\_\_\_\_ Cu.  
 Dry Hole \_\_\_\_\_  
 Abandoned \_\_\_\_\_


Date

NOV 18 1916

E. H. WEST

Scout

Map No. \_\_\_\_\_ Sec. 5 Twp. 22 R. 13  
 Well No. 1 Weaver Farm \_\_\_\_\_  
Barricklow & Donley Company

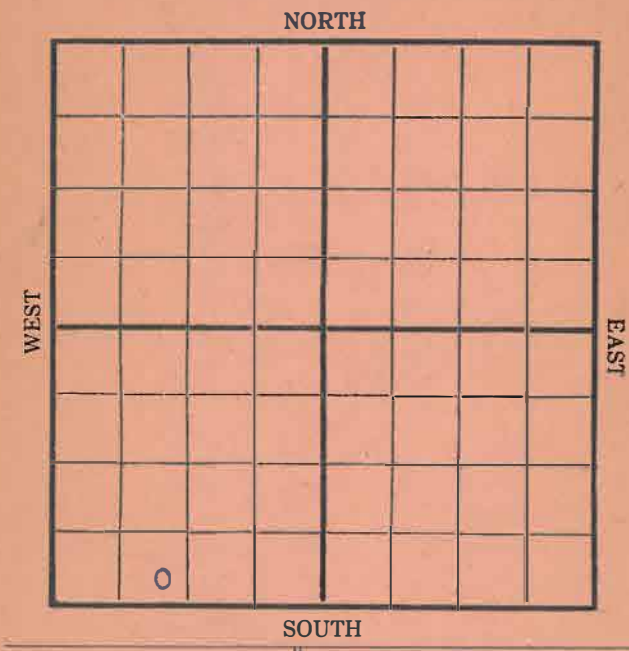

Location \_\_\_\_\_  
 Rig Up \_\_\_\_\_  
 Drilling and remarks \_\_\_\_\_

SD -1000

## RECORD

Cased \_\_\_\_\_ in. \_\_\_\_\_ Ft.  
 Sand \_\_\_\_\_  
 Gas \_\_\_\_\_  
 Oil \_\_\_\_\_  
 Total Depth \_\_\_\_\_

## PRODUCTION

1st 24 hrs. Nat. \_\_\_\_\_  
 1st 24 hrs. after shot \_\_\_\_\_  
 Gas \_\_\_\_\_ Cu. Ft.  
 Dry Hole \_\_\_\_\_  
 Abandoned \_\_\_\_\_


Date

DEC -4 1916

E. H. WEST

Scout

Map No. \_\_\_\_\_ Sec. 5 Twp. 22 R. 13  
 Well No. 1 Weaver Farm \_\_\_\_\_  
Barricklow & Donley Company

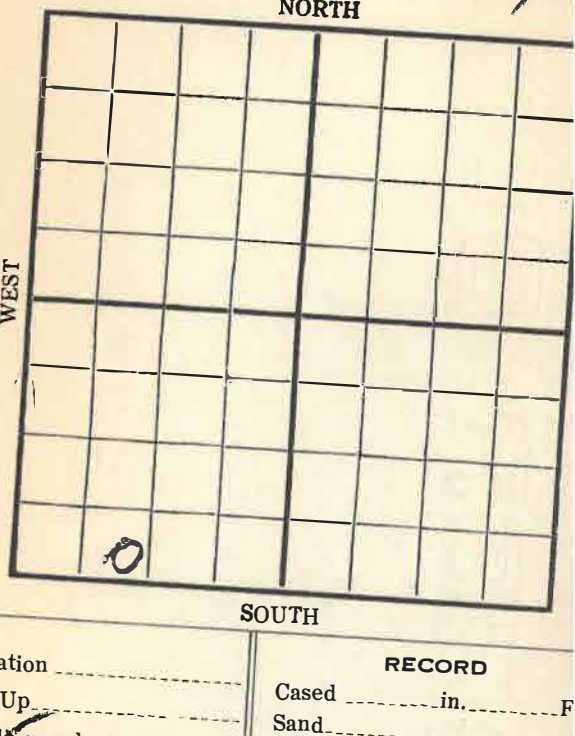

Location \_\_\_\_\_  
 Rig Up \_\_\_\_\_  
 Drilling and remarks \_\_\_\_\_

1400

## RECORD

Cased \_\_\_\_\_ in. \_\_\_\_\_  
 Sand \_\_\_\_\_  
 Gas \_\_\_\_\_  
 Oil \_\_\_\_\_  
 Total Depth \_\_\_\_\_

## PRODUCTION

1st 24 hrs. Nat. \_\_\_\_\_  
 1st 24 hrs. after shot \_\_\_\_\_  
 Gas \_\_\_\_\_ Cu. Ft.  
 Dry Hole \_\_\_\_\_  
 Abandoned \_\_\_\_\_

Date

DEC -9 1916

E. H. WEST

Scout