


DX 78-1

Greenwood KANSAS ✓

Section 5 Township 22 Range 11E

Well No. 2 Curry

Company White & Ellis

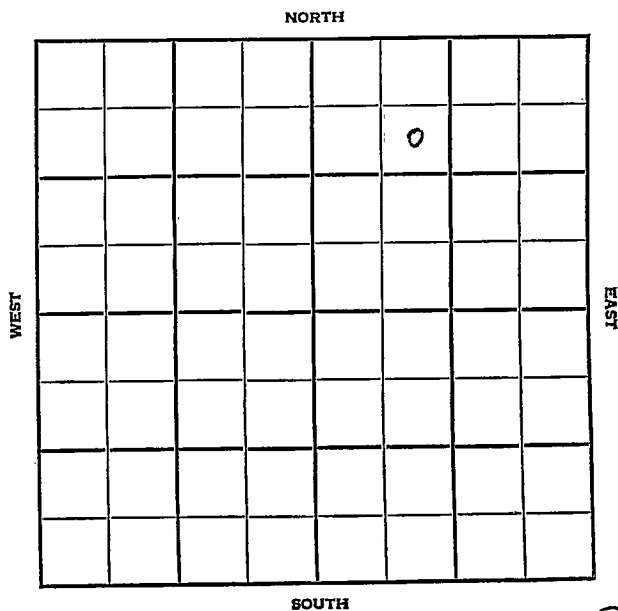

County **Greenwood** State **Kansas**

Sec. **5** (Blk.) **22** (Sur.) **11E** Map No. (Twp.) (Rge.)

Operator **White & Ellis**

Well No. **2** Farm **Curry**

Elev. Location **SE NW NE**

990 Ft. From N Line **NE**

990 Ft. From W Line **Quarter**

1st. Report **SEP 29 1954**

Completion

Remarks

Co. Tools

Spudding Date **9-28-54**

Drlg. Data **Oil well TD 1900**

MIRT

8" @ 90 Bart. 1838 TD 1900 5" @ 1899

32/ 1835-41 21/ 1849-53 24/ 1880-86

B/ 1½ bo 4½ bw 8 hr. sd-frac S/ load

SP 1870 sd-frac S/ 1½ bo 7 bwph

Comp. 20 bopd 50 bw

FABEN GILSTRAP