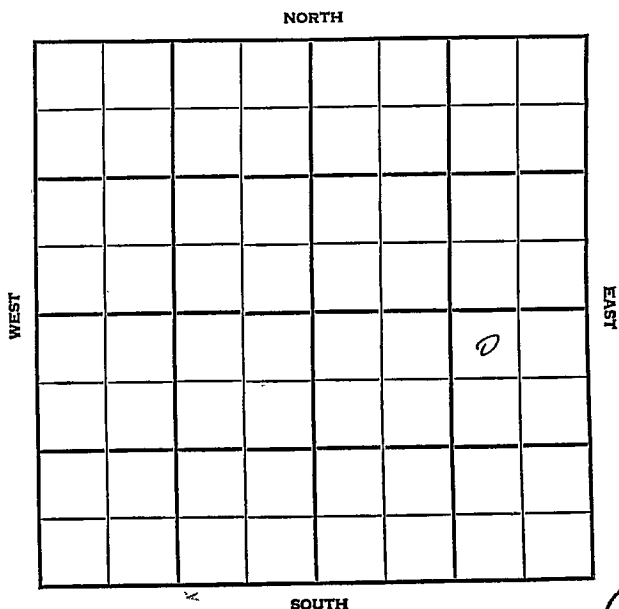


DX 78-1

Greenwood

KANSAS ✓

Section 5 Township 22 Range 11EWell No. #1 Dale CurryCompany White & W. Ellis

Greenwood KANSAS

SEC.	TWP.	R.
5	22	11E

WELL NO.

1 Dale Curry

FARM

COMPANY

White & Ellis

CONTRACTOR

Co. Tools


Bemalorie-Sowder Pool

330 Ft. from N. Line

Ft. from S. Line

990 Ft. from E. Line

Ft. from W. Line

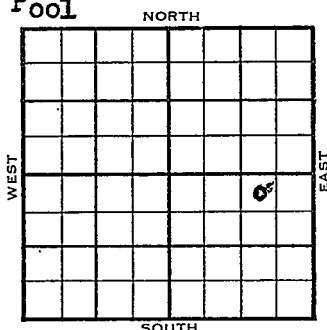

NW NE SE

1954

ELEVATION

REPORT

11/17

Spud 11-2-54

8" @ 85'

Lans 1050', KC 1297', Marm. 1612',

Peru 1645', Cattleman sd 1792',

Bart. 1871', Burg. 2067', Miss 2080',

TD 2195'

5" @ 1915'

12/8

Spud 11-2-54

Oil Well

TD 2195'

8" @ 85'

Lans 1050', KC 1297' Marm 1612'

Per. 1645' Cattleman Sd. 1792' Bart.

1871' Burg. 2067' Miss 2080'

TD 2195'

5" @ 1915'

76/ 1872-83 sd-frac.

Comp 25 bopd.

COMPLETED

County **Greenwood** State **Kansas**

Sec. 5 (Blk. Twp.) 22 (Sur. Rge.) 11E Map No.

Operator **White & Ellis**

Well No. 1 Farm Dale Curry

Elev.	Location	NW	NE	SE
-------	----------	----	----	----

330 Ft. From N Line SE

990 Ft. From Ft. Line. Quarter

1st. Report NOV 17 1954

Completion

Remarks

Co. tools

Spudding Date **11-2-54**

Drlg. Data Bemalorie-Sowder Pool

8ⁿ @ 85 LAns. 1050 KC 1297

Narm. 1612 * Peru 1645 Cattleman sd. 1792

Bart. 1871 Burg. 2067 Miss. 2080

TD 2195 5" @ 1915

FABEN GILSTAD

County	Greenwood		State	Kansas	
Sec.	5	(Blk. Twp.)	22	(Sur. Rge.)	11E Map No.
Operator	White & Ellis				
Well No.	1	Farm	Dale Curry		
Elev.	Location		NW NE SE		

	330 Ft. From	N Line	SE
	990 Ft. From	E Line	Quarter
	1st. Report		
	Completion	DEC 8 1954	
	Remarks	Bemalorie-Sowder Pool	
	Coalttools		
	Spudding Date	11-2-54	
	Drilg. Data	Oil well	TD 2195
	8" @ 85	Lans. 1050	KC 1297
	Marm. 1612	Peru 1645	Cattleman sd.1792
Bart. 1871	Burg. 2067	Miss. 2080	
TD 2195	5" @ 1915	76/ 1872-83	
sd-frac	Comp. 25 bopd		

FABEN GU STRAP