
Marion KANSAS

SECTION 6 TOWNSHIP 22 RANGE 3E

WELL NO. #1 Delbert Wallace

COMPANY E.H. Adair

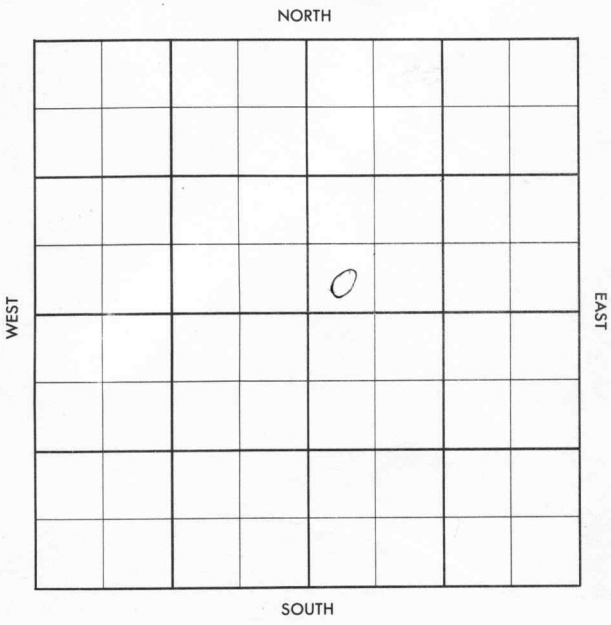

FORM 504-3 SUNRAY

FORM 513 SUNRAY

County Marion Elev.

Sec. 6 Twp. 22 Rge. 3E

Company E. H. Adair

Farm Name Delbert Wallace No. 1

TOPS	DEPTH	LOG	DATUM
Anh.			
T.P.			
H.			
Tr.			
Dg.			
Bl.			
L.			
K.C.			
B.K.C.			
Ce.			
C.			
M.			
M.			
K.			
Mz.			
Mo.			
V.			
S.			
S.			
A			
R.			
P€.			
G.			
T.D.			

Loc. in Sec. SW SW NE

Geol.

Contr. Co. Tools

Pool Doyle Creek



Date Comm. 12-22-56 Anderson-Pric, AC DHM

Drlg. 600

Co. Lse. No. Sec. T. R.

FORM 518 SUNRAY

County Marion Elev. 1434

Sec. 6 Twp. 22 Rge. 3E

Company E. K. Adair

Farm Name Delbert Wallace No. 1


TOPS	DEPTH	LOG	DATUM
Anh.			
Tp.			
H.			
Tr.			
Dg.			
Bl.			
L.		2042	
K.C.			
B.K.C.		2443	
Ce.			
C. Chert		2616	
M. Hunt	2895	2894	
K. Miss Lt		2718	
Mz. Kd		2772	
Me. Sh		2937	
V.	2967	2967	
S.		3262	
S.			
A			
R.			
P€			
G.			
T.D.	3072		

Loc. in Sec. SW SW NE

Geol.

Contr. Co. Tools

Pool Doyle Creek

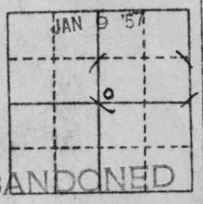

ABANDONED

Date Comm. 12-22-56 Anderson-Pric. AC DHE

Drlg. 600 JAN 2 '57 DST 2895-981 hr

115' SW JAN 9 '57 DST 2855-2901

2 hr. 115' SOIP w/ BHP 1060/20

D&A ~~hold~~

Co. Lse. No. Sec. T. R.