
Marion

SECTION 6 TOWNSHIP 22 RANGE 3E

WELL NO. #1 Windsor

COMPANY Anderson-Prichard

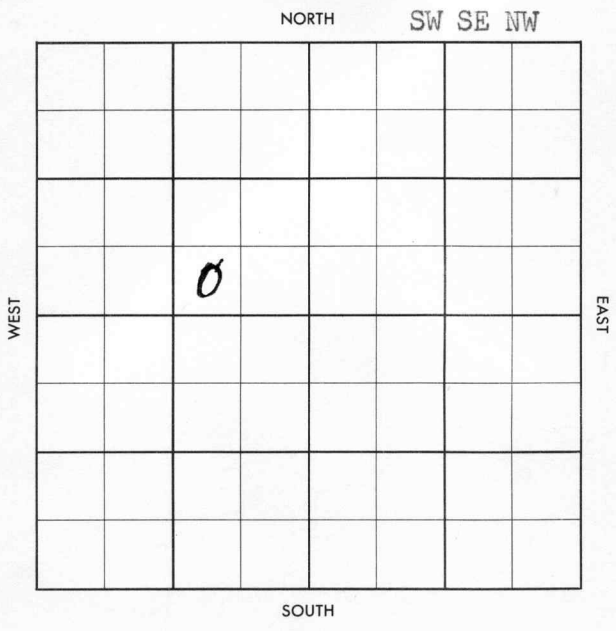

FORM 504-3 SUNRAY

FORM 513 SUNRAY

County Marion Elev.

Sec. 6 Twp. 22 Rge. 3E

Company Anderson-Prichard

Farm Name Windsor No. 1

TOPS	DEPTH	LOG	DATUM
Anh.			
Tp.			
H.			
Tr.			
Dg.			
B.L.			
L.			
K.C.			
B.K.C.			
Ce.			
C.			
M.			
M.			
K.			
Mz.			
Mo.			
V.			
S.			
S.			
A			
R.			
P€.			
G.			
T.D.			

Loc. in Sec. SW SE NW

Geol.

Contr. Peel Bros.

Pool Doyle

FIRST REPORT

MAY 22 57

Date Comm.

Location

Co. Lse. No. Sec. T. R.

FORM 513 SUNRAY

County Marion Elev. 1428

Sec. 6 Twp. 22 Rge. 3E

Company A nderson-Prichard

Farm Name Windsor No. 1

TOPS	DEPTH	LOG	DATUM
Anh.			
Tp.			
H.			
Tr.			
Dg.			
B.L.			
L.			
K.C.			
B.K.C.			
Ce.			
C.			
M.	2626		
M.	2768		
K.	2901		
Mz. Hunt	2945		
Mo.	2973		
V.			
S.			
S.			
A			
R.			
P€.			
G.			
T.D.	2987		

Loc. in Sec. SW SE NW

Geol.

Contr. Peel Bros.

Pool Doyle

MAY 29 '57

ABANDONED

Date Comm.

Location MAY 29 '57 5-21-57 P5/8

220

D & A

Co. Lse. No. Sec. T. R.