

Map No. _____ Sec. 6 Twp. 22 R. 4


Well No. 1 Bothwell Farm
Watson Etal Company

_____ Ft. from N. Line

660 Ft. from S. Line

200 Ft. from E. Line

_____ Ft. from W. Line

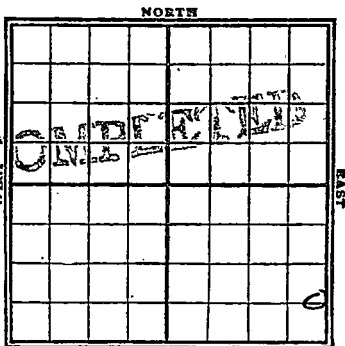

FLUOR REPORT

Date

REPORT

7/2	J O G.
9	Reg up
16	Loes
23	Loes
31	Spudding
8	Spud & so
15	Spud so for water
22	Dry 600'
29	✓ 1100'
4/12	✓ 1500
24	✓ 1850
30	Fish Loes 2200
5/3	2300
10	HFW 2565
22	H.F.W. 2565
25	plugged back to 2425' will shut
31	-
6/7	2370-2425' light down Dry hole

Map No. K 23 Sec. 6 Twp. 22 R. 4

Well No. 1 Bothwell
Hatchorn et al Company

Contractor _____

SECTION PLAT

_____ Ft. from N. Line
660 Ft. from S. Line
200 Ft. from E. Line
 _____ Ft. from W. Line

			0

EXACT REPORT

Location _____

Rig up _____

Drilling and Remarks:

J. O. G.

RECORD

Cased _____ in., _____ ft.

Sand _____

Gas _____

Oil _____

Total Depth _____

PRODUCTION

1st 24 hrs. Nat. _____

1st 24 hrs. after shot _____

Gas _____ Cu. Ft

Dry Hole _____

Abandoned _____

Date

2/2 1910

1073

Map No. K 23 Sec. 6 Twp. 22 R. 4Well No. 1 BothwellHatchorn et al Company

Contractor

SECTION PLAT

Ft. from N. Line

660 Ft. from S. Line200 Ft. from E. Line

Ft. from W. Line

COMPLETED

Location _____

Rig up _____

Drilling and Remarks:

RECORD

Cased _____ in., _____ ft.

Sand 2370 - 2425

Gas _____

Oil light show

Total Depth _____

PRODUCTION

1st 24 hrs. Nat. _____

1st 24 hrs. after shot _____

Gas _____ Cu. Ft.

Dry Hole 2611

Abandoned _____

Date

6/7 1920

Pyle

Scout

MAP NO. _____ SEC. 6 TWP. 22S 4E

WELL NO. 1 Bathwell
Watchorn et al COMPANY

CONTRACTOR _____

SECTION PLAT

			o

_____ FT. FROM N. LINE
 _____ FT. FROM S. LINE
 _____ FT. FROM E. LINE
 _____ FT. FROM W. LINE

LOCATION _____

RIG UP _____

DRILLING AND REMARKS:

*crack spotted
 no good*

RECORD

CASED _____ IN. _____ FT.
 SAND _____
 GAS _____
 OIL _____
 TOTAL DEPTH 110 1/2

PRODUCTION

1ST 24 HRS. NAT. _____
 1ST 24 HRS. AFTER SHOT _____
 GAS _____ CU. FT.
 DRY HOLE
 ABANDONED _____

DATE

6/7 1920

SCOUT