


Map No. _____ Sec. 6 Twp. 22 R. 5

Well No. 1 Jolliffe Farm

Kan. O. & T. Ref. Company

NORTH

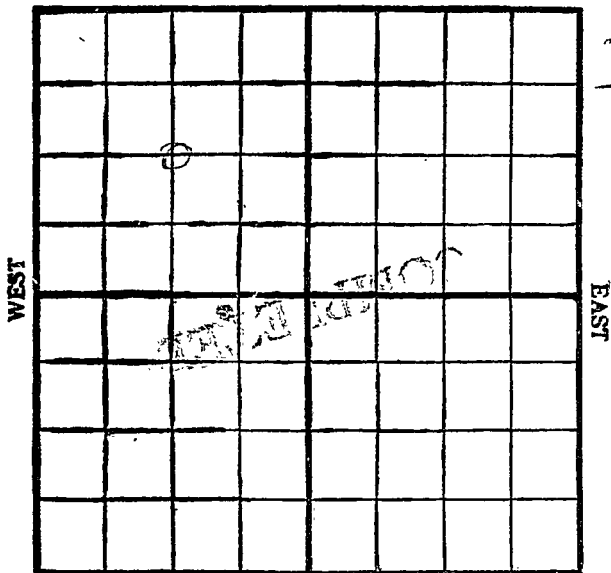

SOUTH

Location _____

Rig Up _____

Drilling Remarks:

Drilling Remarks:

8-16-19

dry & above

25-27'

RECORD

PRODUCTION

Cased _____ in. _____ ft.

1st 24 hrs. Nat. _____

Sand _____

1st 24 hrs. after shot _____

Gas _____

Gas _____ cu. ft.

Oil _____

Dry Hole _____


Total Depth _____

Abandoned _____

Map No. K23 Sec. 6 Twp. 22 R. 5Well No. 1 Holliffe
Kanated Ref- Company _____

Contractor _____

NORTH

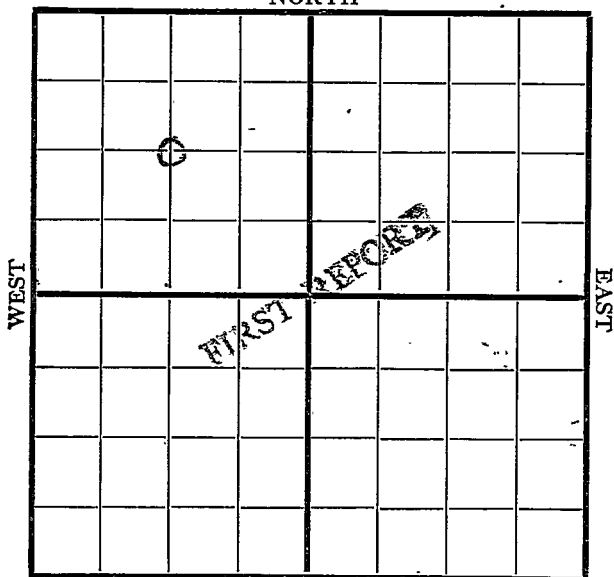

SOUTH

Location 1320 N-WRig up ☒

Drilling and Remarks:

RECORD

Cased _____ in., _____ ft.

Sand _____

Gas _____

Oil _____

Total Depth _____

PRODUCTION

1st 24 hrs. Nat. _____

1st 24 hrs. after shot _____

Gas _____ Cu. Ft.


Dry Hole _____

Abandoned _____

Date

11/14 1918 G. y. u Scout

Map No. K 23 Sec. 6 Twp. 22 R. 5
Well No. 1 Joliffe
Kan Oil & Fuel Ref Company
Contractor

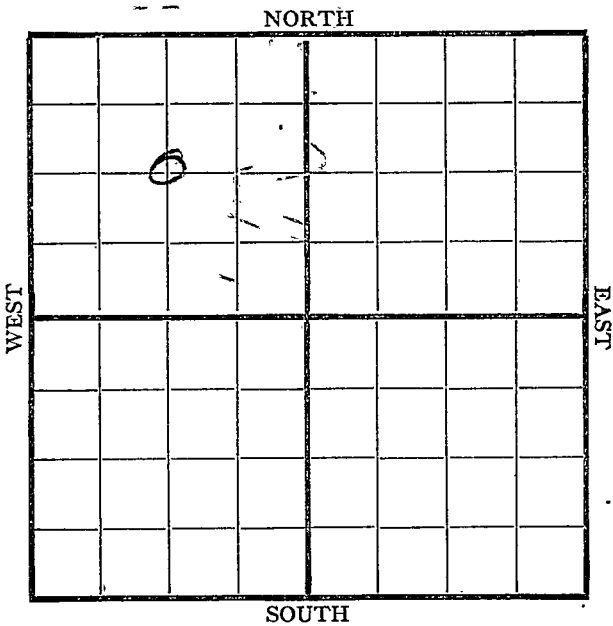

Location _____ Rig up _____ Drilling and Remarks: <u>D. D.</u> <u>H.F.W.</u> <u>2550'</u>	RECORD
	Cased _____ in., _____ ft.
	Sand _____
	Gas _____
	Oil _____
	Total Depth _____
	PRODUCTION
	1st 24 hrs. Nat. _____
	1st 24 hrs. after shot _____
	Gas _____ Cu. Ft.
	Dry Hole _____
	Abandoned _____


Date 6/18 1919 P.V.I. Scout

Map No. K 23 Sec. 6 Twp. 22 R. 5
 Well No. 1 Jolliffe
Kanotas Ref. _____ Company _____
 Contractor _____

NORTH

WEST

EAST

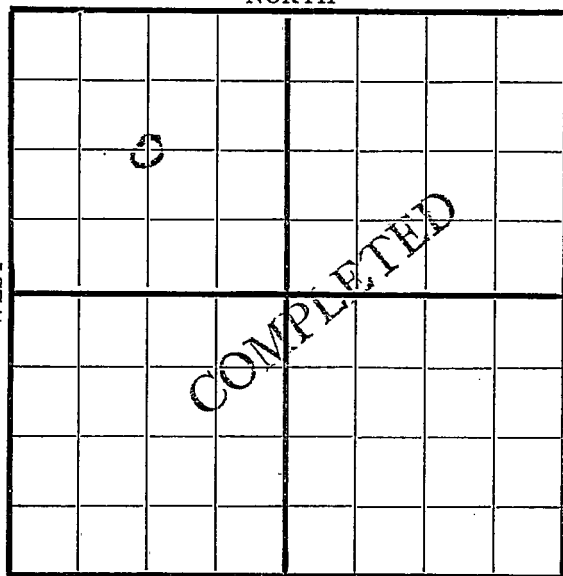

1320 N-W SOUTH

Location _____

Rig up _____

Drilling and Remarks:

RECORD

Cased _____ in., _____ ft.

Sand _____

Gas _____

Oil _____

Total Depth _____

PRODUCTION

1st 24 hrs. Nat. _____

1st 24 hrs. after shot _____

Gas _____ Cu. Ft.

Dry Hole. 2527

Abandoned _____

Date

8/11

1919

Scout