


Map No. **KANSAS** Sec. **6** Twp. **22** R. **10**
 Well No. **4 A type** Farm _____
Empire Company _____

NORTH

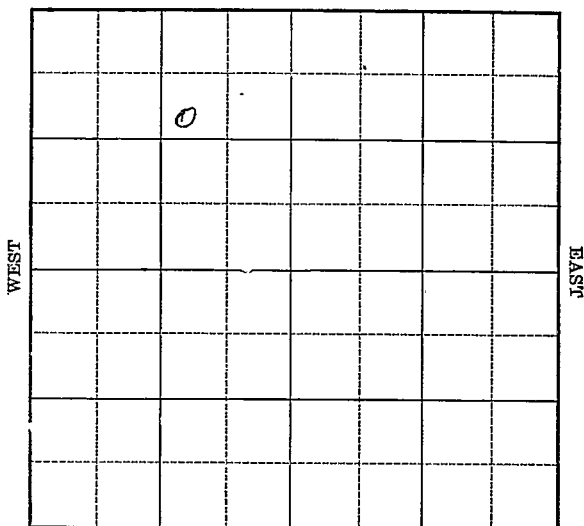

SOUTH

Location _____

Drilling Remarks _____

Rig Up _____

Drilling Remarks _____

RECORD

Cased _____ in. _____ ft.

Sand _____

Gas _____

Oil _____

Total Depth _____

PRODUCTION

1st 24 hrs. Nat. _____

1st 24 hrs. after shot _____

Gas _____ cu. ft.

Dry Hole _____

Abandoned _____


Greenwood

Map No. _____ Sec. 6 Twp. 22 R. 10Well No. 4 Atyeo Farm _____Empire Gr 7 Company _____990 Ft. from N. Line

_____ Ft. from S. Line

990 Ft. from E. Line

_____ Ft. from W. Line

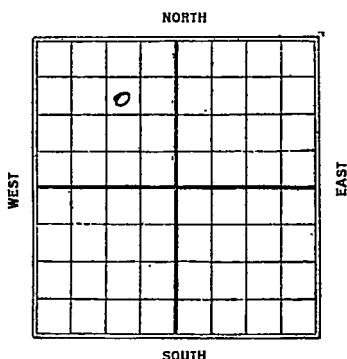1926

REPORT

1/8 Location1/4 Rig2/20 Rigged up.2/212/21 Dlg 285'2/20 ✓ 855'2/17 10' collapsed 13' 62'2/24 Drlg 14003/53/10 " 285'3/18 Sand 2204-2241

TD 2245 80 gts

155 bbls

21 KANSAS 6 Twp. 22 R. 10
 Map No. Sec. Twp. R.

Well No. 4 HYE
 Empire Oil & Fuel Company

Contractor

FIRST REPORTS

SECTION PLAT

990 Ft. from N. Line

Ft. from S. Line

990 Ft. from E. Line

Ft. from W. Line

	o		

Location ✓

Rig up

Drilling and Remarks:

RECORD

Cased _____ in., _____ ft.

Sand _____

Gas _____

Oil _____

Total Depth _____

PRODUCTION

1st 24 hrs. Nat. _____

1st 24 hrs. after shot _____

Gas _____ Cu. Ft.

Dry Hole _____

Abandoned _____

Date

JAN 8 1926

CHAS. L. SHERWOOD
 Scout

Sherwood
 K21 Map No. **KANSAS** Sec. **6** Twp. **22** R. **10**
 Well No. **4** *type*
Com Air Gas Fuel Company

Contractor

COMPLETED

SECTION PLAT

990

Ft. from N. Line

Ft. from S. Line

990

Ft. from E. Line

Ft. from W. Line

	0		

Location

Rig up

Drilling and Remarks:

Sdy Shale 2176-
2204'

RECORD

Cased _____ in., _____ ft.

Sand **2204-2241'**

Gas _____

Oil _____

Total Depth **2245'**

PRODUCTION

1st 24 hrs. Nat. _____

1st 24 hrs. after shot _____

Gas _____ Cu. Ft.

Dry Hole _____

Abandoned _____

807 155 Bls.

Date

MAR 18 1926

Scout
CHAS. L. SHERWOOD
 Scout