

Map No. Range Sec. 6 Twp. 22 R. 10

Well No. 6 Atypes, Farm _____

Empire G. F. Co. Company

NORTH

WEST

0

EAST

SOUTH

Location _____

Drilling Remarks

Rig Up

Drilling Remarks

RECORD

Cased _____ in. _____ ft.

Sand

Gas

Oil

Total Depth _____

PRODUCTION

1st 24 hrs. Nat.

1st 24 hrs. after shot _____

Gas_____cu. ft.

Dry Hole_____

Abandoned _____

Map No. 140 Sec. 6 Twp. 22 R. 10

Well No. 6 Steps Farm

Empire L. & F. Company


NORTH

----- Ft. from N. Line

990 Ft. from S. Line

330 Ft. from E. Line

-----Ft. from W. Line

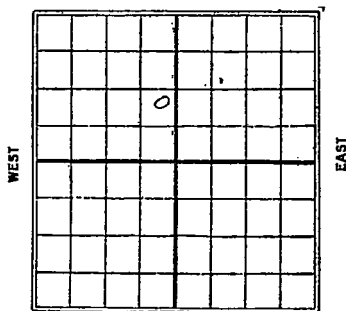

SOUTH

Date 7/9/26

REPORT

3/11	Building Reg
3/18	

3/18	
3/25	Riggin
4/1	Box 510
1/1	

4/7 S.D. 545-

4/21	Drilling 1345
11/2	

4/30	1815
------	------

5/8	"	2080
-----	---	------

5/19	Sand. 2193-2260' I.D.
	140/240 bbls.

Greenwood
 K21 KANSAS Sec. 6 Twp. 22 R. 10
 Map No. _____

Well No. *6 atypes*
Empire Gas & Oil Co. Company
 _____ Contractor

SECTION PLAT

_____Ft. from N. Line

990 Ft. from S. Line*330* Ft. from E. Line

_____Ft. from W. Line

	0		

FIRST REPORTS

Location _____

Rig up _____

Drilling and Remarks:

Building Rig

RECORD

Cased _____ in., _____ ft.

Sand _____

Gas _____

Oil _____

Total Depth _____

PRODUCTION

1st 24 hrs. Nat. _____

1st 24 hrs. after shot _____

Gas _____ Cu. Ft.

Dry Hole _____

Abandoned _____

Date

MAR 1 1 1926

CHAS. L. SHERWOOD

192

Scout

Sherwood
 K21 KANSAS Sec. *6* Twp. *22* R. *10*
 Map No. _____
 Well No. *6* *kyeo*
Compin & Co _____ Company

_____ Contractor

COMPLETED

_____ Ft. from N. Line

990 _____ Ft. from S. Line

330 _____ Ft. from E. Line

_____ Ft. from W. Line

SECTION PLAT

	o		

Location _____

Rig up _____

Drilling and Remarks:

140' 240' ss.

RECORD

Cased _____ in., _____ ft.

Sand *2192-2260'*

Gas _____

Oil _____

Total Depth *2260'*

PRODUCTION

1st 24 hrs. Nat. _____

1st 24 hrs. after shot. _____

Gas _____ Cu. Ft.

Dry Hole _____

Abandoned _____

Date

MAY 12 1926

192

CHAS. L. SHERWOOD

Scout