


Map No. Kansas Sec. 6 Twp. 22 R. 10Well No. 4 Attyeo FarmKanson Oil Corp Company

NORTH

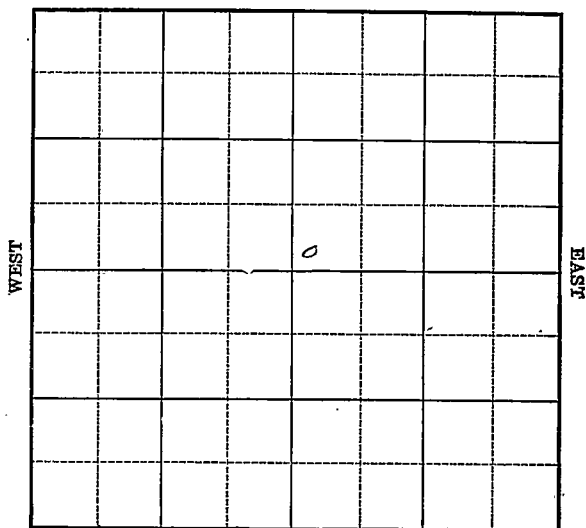

SOUTH

Location _____

Drilling Remarks

Rig Up _____

Drilling Remarks

RECORD

Cased _____ in. _____ ft.

Sand _____

Gas _____

Oil _____

Total Depth _____

PRODUCTION

1st 24 hrs. Nat. _____

1st 24 hrs. after shot _____

Gas _____ cu. ft.

Dry Hole _____

Abandoned _____


Greenwood

Map No. Kansas Sec. 6 Twp. 22 R. 10Well No. 4 Atty FarmKanson Oil Corp Company

Ft. from N. Line

330 Ft. from S. Line

Ft. from E. Line

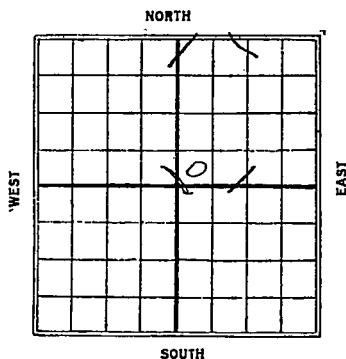330 Ft. from W. Line

Date

REPORT

19265/26 R. O. G.6/2 drill 300'6/10 " 4506/18 " 9006/25 " 12006-30 " 21157/8 top sand 2227-55Shot 120 gts. C.O.7/14 sand 2227-2255T.O. 2255-120/120 bbls

K-21 KANSAS

Map No. _____ Sec. 6 Twp. 22 R. 10Well No. 4 StycoSanborn Oil Corp Company_____
Contractor

FIRST REPORTS

Ft. from N. Line330 Ft. from S. Line_____
Ft. from E. Line330 Ft. from W. Line

SECTION PLAT

Location _____

Rig up _____

Drilling and Remarks: _____

Roby.

RECORD

Cased _____ in., _____ ft.

Sand _____

Gas _____

Oil _____

Total Depth _____

PRODUCTION

1st 24 hrs. Nat. _____

1st 24 hrs. after shot _____

Gas _____ Cu. Ft.

Dry Hole _____

Abandoned _____

Date

MAY 26 1926

CHAS. L. SHERWOOD

192

Scout

K21

KANSAS

Map No. _____ Sec. 16 Twp. 22 R. 10Well No. 4London Oil Corp Company

Contractor _____

COMPLETED

SECTION PLAT

_____ Ft. from N. Line

330

_____ Ft. from S. Line

_____ Ft. from E. Line

330

_____ Ft. from W. Line

Location _____

Rig up _____

Drilling and Remarks:

1207 120 SS.

RECORD

Cased _____ in., _____ ft.

Sand 2227-2255

Gas _____

Oil _____

Total Depth 2255

PRODUCTION

1st 24 hrs. Nat. _____

1st 24 hrs. after shot _____

Gas _____ Cu. Ft.

Dry Hole _____

Abandoned _____

Date

JUL 14 1926

CHAS. L. SHERWOOD

192

Scout