


Map No. 4 ^{Chances.} Sec. 6 Twp. 22 R. 10
 Well No. 5 Atypes Farm
Empire G. F. Co Company

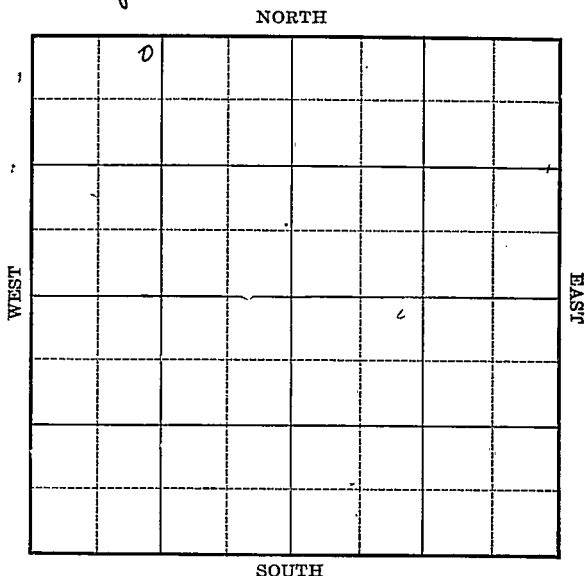

Location _____

Drilling Remarks

Rig Up _____

Drilling Remarks

RECORD

Cased _____ in. _____ ft.

Sand _____

Gas _____

Oil _____

Total Depth _____

PRODUCTION

1st 24 hrs. Nat. _____

1st 24 hrs. after shot _____

Gas _____ cu. ft.

Dry Hole _____

Abandoned _____

Map No. 1 Kansas Sec. 6 Twp. 22 R. 10Well No. 5 Steps FarmEmpire L. & F. Company

NORTH

330 Ft. from N. Line

_____ Ft. from S. Line

_____ Ft. from E. Line

820 Ft. from W. Line

WEST

EAST

SOUTH

Date

REPORT

1926

<u>3/11</u>	<u>Location</u>
<u>3/18</u>	<u>Bldg rig</u>
<u>3/25</u>	<u>Slg 400</u>
<u>4/1</u>	<u>" 1319</u>
<u>4/7</u>	<u>" 1800</u>
<u>4/15</u>	<u>Top sd-2230-2250' I.D.</u>
	<u>2254' shot 60/52 bbls.</u>
	<u>1st, 11 hours. Cleaning</u>
	<u>out and swabbing</u>
<u>4/21</u>	<u>sd-2230-2250' I.D. 2254'</u>
	<u>60/100 Bbls.</u>

K21 KANSAS Sec. 6 Twp. 22 R. 10

Well No. 5 Atepo

Empire Gas & Co. Company

Contractor

SECTION PLAT

330 Ft. from N. Line

Ft. from S. Line

Ft. from E. Line

820 Ft. from W. Line

FIRST REPORTS

0			

Location

Rig up

Drilling and Remarks:

RECORD

Cased _____ in., _____ ft.

Sand _____

Gas _____

Oil _____

Total Depth _____

PRODUCTION

1st 24 hrs. Nat. _____

1st 24 hrs. after shot _____

Gas _____ Cu. Ft.

Dry Hole _____

Abandoned _____

Date

MAR 1 1 1926

CHAS. L. SHERWOOD

192 Scout

1021 KANSAS Sec. 6 Twp. 22 R. 10
 Map No. 5
 Well No. 5
 Complete 5000 Co. Company
 Contractor

COMPLETED

SECTION PLAT

330 Ft. from N. Line

Ft. from S. Line

Ft. from E. Line

820 Ft. from W. Line

0			

Location

Rig up

Drilling and Remarks:

600 100 88

RECORD

Cased _____ in. _____ ft.
 Sand 2230-2250
 Gas _____
 Oil _____
 Total Depth 2254

PRODUCTION

1st 24 hrs. Nat. _____
 1st 24 hrs. after shot _____
 Gas _____ Cu. Ft.
 Dry Hole _____
 Abandoned _____

Date

APR 21 1926

CHAS. L. SHERWOOD

192

Scout