


Map No. Kano. Sec. 6 Twp. 22 R. 10
 Well No. # 8. Atges Farm
Empire G-F. Company

_____ Ft. from N. Line

330 Ft. from S. Line

330 Ft. from E. Line

_____ Ft. from W. Line

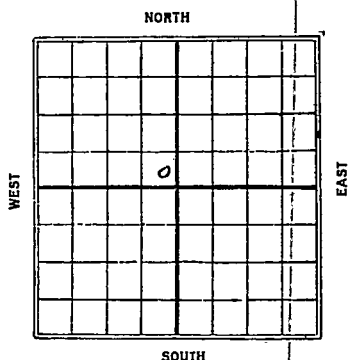

1926.

Date

REPORT

5/19 Location

6/2 Drlg. 300'

6/10 " 1125

6/18 " 1640

6/25 - top sand 2216-2246'

T.D. 2248' will shoot

6/30 Sand 2216-2246 T.D. 2248

140 gts 355 bbls

Steenwood
 K-21 KANSAS Sec. *6* Twp. *22* R. *10*
 Map No. *8* *Styeo*
 Well No. *6 on p 10 8 Q I Co* Company

Contractor

FIRST REPORTS

Ft. from N. Line

330

Ft. from S. Line

330

Ft. from E. Line

Ft. from W. Line

SECTION PLAT

Location ☒

Rig up

Drilling and Remarks:

RECORD

Cased _____ in., _____ ft.

Sand _____

Gas _____

Oil _____

Total Depth _____

PRODUCTION

1st 24 hrs: Nat. _____

1st 24 hrs. after shot _____

Gas _____ Cu. Ft.

Dry Hole _____

Abandoned _____

Date

MAY 12 1926

192

CHAS. L. SHERWOOD

Scout

Sherwood
 K21 KANSAS Sec. 6 Twp. 22 R. 10
 Map No. 8 atypeo
 Well No. Enfilb 527 Co. Company

Contractor

COMPLETED

SECTION PLAT

_____ Ft. from N. Line

330 _____ Ft. from S. Line

330 _____ Ft. from E. Line

_____ Ft. from W. Line

Location _____

Rig up _____

Drilling and Remarks:

142 / 355 ss.

RECORD

Cased _____ in., _____ ft.

Sand 2216-2246'

Gas _____

Oil _____

Total Depth 2248'

PRODUCTION

1st 24 hrs. Nat. _____

1st 24 hrs. after shot _____

Gas _____ Cu. Ft.

Dry Hole _____

Abandoned _____

Date

JUN 30 1926

CHAS. L. SHERWOOD

192

Scout