


Section 6 Township 22 Range 10 E

Well No. # 4 Atyeo "C"

Company Cities Service

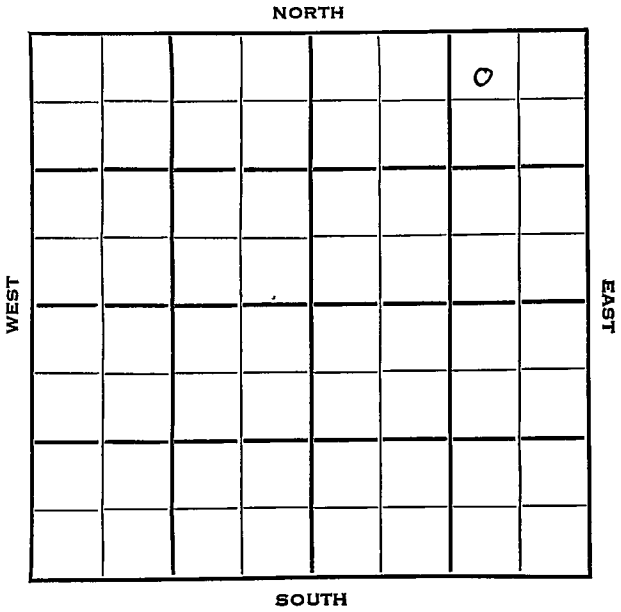

**Greenwood KANSAS**

SEC. <div style="text-align: center; font-size: 24px;">6</div>	TWP. <div style="text-align: center; font-size: 24px;">22</div>	R. <div style="text-align: center; font-size: 24px;">10 E</div>
---	--	--

WELL NO.

# 4 Atyeo "C"


FARM

COMPANY

**Cities Service**

CONTRACTOR

\_\_\_\_\_ Ft. from N. Line  
 2250 \_\_\_\_\_ Ft. from S. Line  
 990 \_\_\_\_\_ Ft. from E. Line  
 \_\_\_\_\_ Ft. from W. Line  
 NW NE NE

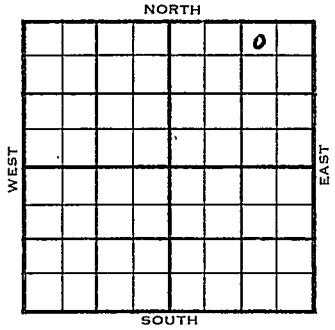

<b>1953</b>	ELEVATION 1344'	REPORT
-------------	--------------------	--------

12/2

Oil well TD 2387' Bart 2227'  
 Miss. 2314' TD 2387' 7" @ 2387'  
 CO to 2377 72/2332-50 1000 A  
 Comp. 54 BOPD 162 BW

**FIRST REPORT**  
 ↓  
**COMPLETED**

