

Section 6 Township 22 Range 10E

Well No. #18 Atyeo

Company Cities Service Oil Company

NORTH

					0		

7

WEST

EAST

SOUTH

Greenwood

KANSAS

Sec. 6 Twp. 22 R. 10E

Well No. #18 Atyeo Farm

Cities Service Oil Company Company

Contractor


Ft. from N. Line

990 Ft. from S. Line

Ft. from E. Line

990 Ft. from W. Line

NE SW NE

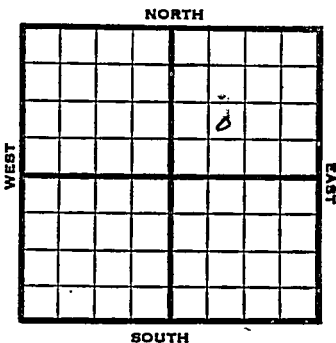

1953 Elev. - REPORT

3/11 10" @ 65
Drlg. 820

4/1 Oil well TD 2376 10" @ 65
Bart 2282 TD 2376 7" @ 2284
CO to 2376 70 qt/2297-2343
2 BO 3 BWPH
Comp. 15 BOPD

COMPLETED

