
FORM 51

Greenwood KANSAS

Section 6 Township 22 Range 10E

Well No. 6 Atyeo "C"

Company Cities Service

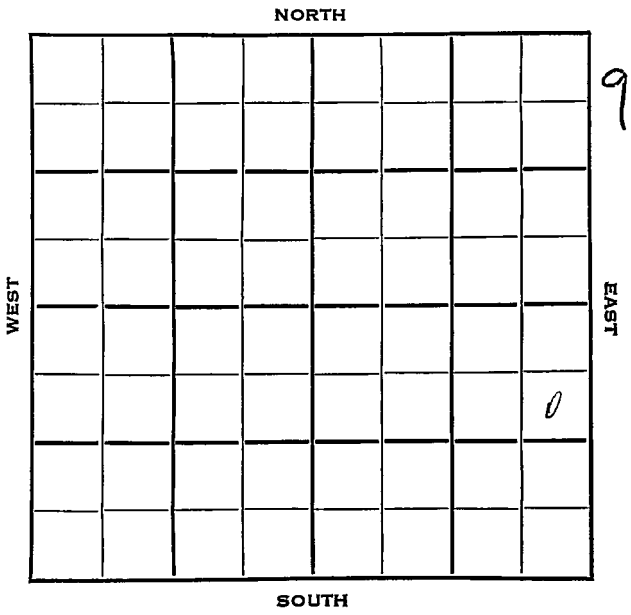

Greenwood KANSAS

SEC.	TWP.	R.
6	22	10E

WELL NO.

6 Atyeo "C" FARM

COMPANY

Cities Service


CONTRACTOR

990 Ft. from N. Line

_____ Ft. from S. Line

330 Ft. from E. Line

_____ Ft. from W. Line

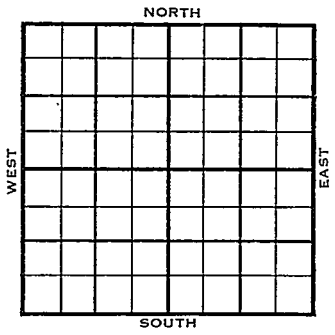

SE NE SE

	ELEVATION	REPORT
1954	1377' RB	

1/13

Oil Well
TD 2422'
8" @ 67'
Bart 2260', Miss 2354'
TD 2422'
5" @ 2421'
47/2370-80, 24/2359-63, 1 boph 2 hrs.
H-frac
Comp. 28 bopd 8 bw

FIRST REPORT

COMPLETED

DX-78

FORM 275 FOR SALE BY KANSAS BLUE PRINT CO.


County Greenwood State Kansas

Sec. 6 (Blk. Twp.) 22 (Sur. Rge.) 10E Map No.

Operator Cities Service

Well No. 6 Farm Atyeo "C"

Elev. 1377 RB Location SE NE SE

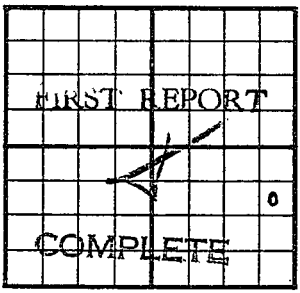

990 Ft. From N Line SE

330 Ft. From E Line Quarter

1st. Report JAN 13 1954

Completion JAN 13 1954

Remarks

Spudding Date

Drlg. Data Oil well TD 2422

8" @ 67 Bart. 2260 Miss. 2354 TD 2422

5" @ 2421 47/ 2370-80 24/ 2359-63

1 boph 2 hr. H-frac Comp. 28 bopd 8 bw

J. G. McGEHEE