

Section 6 Township 22 Range 10EWell No. 8 Atyeo "C"Cities Service

Company _____

NORTH

WEST

EAST

SOUTH

10

0

Greenwood

KANSAS

SEC.	TWP.	R.
6	22	10E

WELL NO.

#8 Atyeo "C"

FARM

COMPANY

Cities Service

CONTRACTOR

White & Ellis

Teeter Pool

990


Ft. from N. Line

Ft. from S. Line

Ft. from E. Line

990

Ft. from W. Line

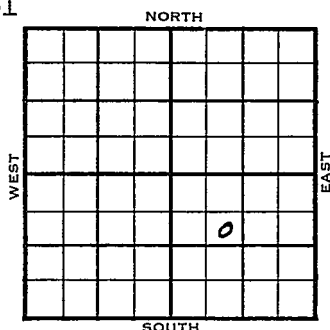

SE NW SE

ELEVATION

REPORT

1955

1375' RB

3/9

Oil Well

TD 2328'

Bart. 2262'

TD 2311'

5" @ 2278'

DD 2328'

50 qt 2294-2328 CO to 2328'

Comp 48 bopd.

**FIRST REPORT
COMPLETED**

County Greenwood State Kansas
 Sec. 6 (Blk. 22 (Sur. 10E Map No.
 (Twp.) (Rge.)
 Operator Cities Service
 Well No. 8 Farm Atyeo "C"
 Elev. 1375 RB Location SE NW SE

FIRST REPORT
COMPLETE

990 Ft. From N Line SE
990 Ft. From W Line Quarter
 Ist. Report MAR 9 1955
 Completion MAR 9 1955
 Remarks Teeter Pool
White & Ellis - Contr.
 Spudding Date

Drlg. Data Oil well TD 2328
Bart. 2262 TD 2311 5" @ 2278
DD 2328 50 qt/ 2294-2328 CO to 2328
Comp. 48 bopd

FABEN GILSTRAP