DX 78-1


Greenwood

KANSAS

Section 6 Township 22 Range 10E

Well No. ~~#2 W Atyeo~~ "C"

Company Cities Service

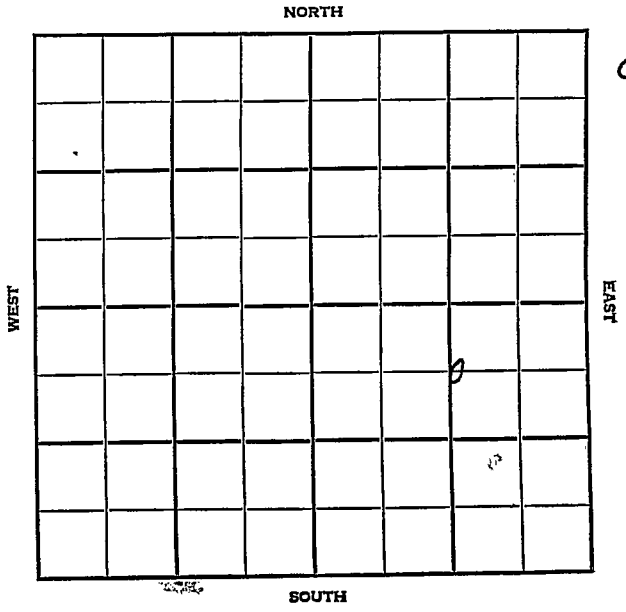

Greenwood KANSAS

SEC.	TWP.	R.
6	22	10E


WELL NO.

24W Atyeo "C" FARM

COMPANY

Cities Service

CONTRACTOR

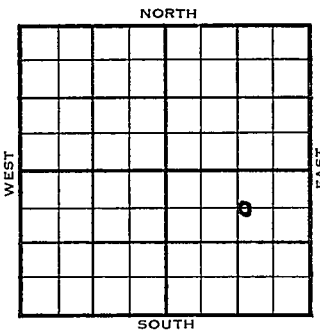

_____ Ft. from N. Line

1965 Ft. from S. Line

1240 Ft. from E. Line

_____ Ft. from W. Line

C N/2 SE/4

1955	ELEVATION	REPORT
1/12		Oil Well TD 2311' 8" @ 67' Bart. 2256', Bart. sd 2260' TD 2311' 5" @ 2265' CO to 2311' 35 qt CO to 2307' Comp. 57 bopd

FIRST REPORT

&

COMPLETED

DX-78

FORM 275 FOR SALE BY KANSAS BLUE PRINT CO.


County Greenwood State Kansas

Sec. 6 (Blk. Twp.) 22 (Sur. Rge.) 10E Map No.

Operator Cities Service

Well No. 24W Farm Atyeo "C"

Elev. Location C N½ SE¼

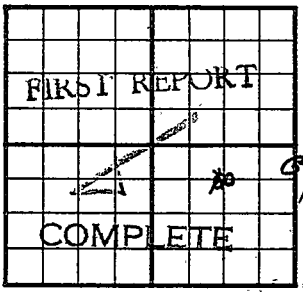

1965 Ft. From S Line SE

1240 Ft. From E Line Quarter

1st. Report JAN 12 1955

Completion JAN 12 1955

Remarks

Spudding Date

Drlg. Data Oil well TD 2311

8" @ 67 Bart. 2256 Bart. sd. 2260

TD 2311 5" @ 2265 CO to 2311

35 qt/. CO to 2307 Comp. 67 bopd

FABEN GUSTAFSON