


Greenwood County ✓

Section 6 **KANSAS** Township 22 Range 12E
Well No. #1 Hensley
Company J. K. Walker et al

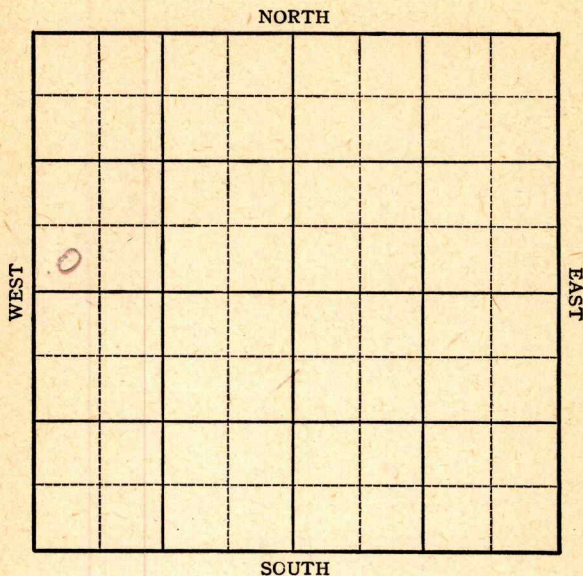

KANSAS

Greenwood County

Sec. 6 Twp. 22 R. 12E

Well No. #1 Hensley Farm

J. K. Walker et al Company

Miscellaneous

Ft. from N. Line

330


Ft. from S. Line

Ft. from E. Line

330

Ft. from W. Line

SW NW

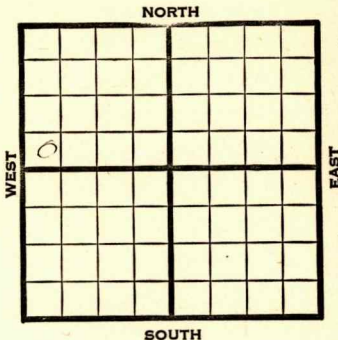

1945

REPORT

3/28 12" @ 385
Drlg. 390'
4/5 Drlg. 860'
4/12 10" @ 900
Drlg. 1240
4/20 Drlg. 1370'

4/27 **Bart** 1768-97
TD 1797
5" @ 1765
Shot 100 qts.

5/2 **Bart** 1768
5" @ 1765
TD 1797
100 qts.
Pump 50 Pot.
Grav. 38.0

COMPLETED

Kansas Pool Name MiscellaneousMap No. 21 Sec. 6 Twp. 22 R. 12EWell No. 1 HensleyJ. K. Walker etal Company**COMPLETED**

Contractor

SW NW

SECTION PLAT

6			

 Ft. from N. Line330 Ft. from S. Line Ft. from E. Line330 Ft. from W. LineGreenwood CountyLocation Rig up

Drilling and Remarks:

*Bar 4/768**5' @ 1765**1009 ft.**Pump 50 ft**35° S***RECORD**Cased in., ft.Sand Gas Oil Total Depth 1792**PRODUCTION**1st 24 hrs. Nat. 1st 24 hrs. after shot Gas Cu. Ft.Dry Hole Abandoned

Date

MAY 2 1945 19 S. J. LEWIS Scout

Pool Name MiscellaneousMap No. 21 Sec. 6 Twp. 22 R. 12EWell No. 1 HensleyJ. K. Walker et al CompanyFIRST REPORT Contractor

SW NW

SECTION PLAT

0			

Ft. from N. Line330 Ft. from S. LineFt. from E. Line330 Ft. from W. LineGreenwoodLocation Rig up

Drilling and Remarks:

12" - 38 5390

RECORD

Cased in., ft.Sand Gas Oil Total Depth

PRODUCTION

1st 24 hrs. Nat. 1st 24 hrs. after shot Gas Cu. Ft.Dry Hole Abandoned

Date

MAR 28 1945 19S. J. LEWIS Scout