


Section 6 Township 22 Range 12E

Well No. #2 Hensley

Company Keith Walker

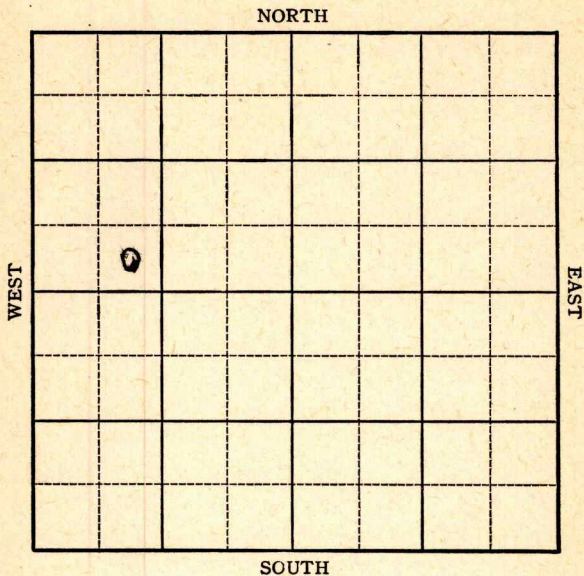

KANSAS

Sec. 6 Twp. 22- R. 12-E

Well No. #2 Hensley Farm

Keith Walker Company


Miscellaneous

 Ft. from N. Line

330 Ft. from S. Line

 Ft. from E. Line

990 Ft. from W. Line

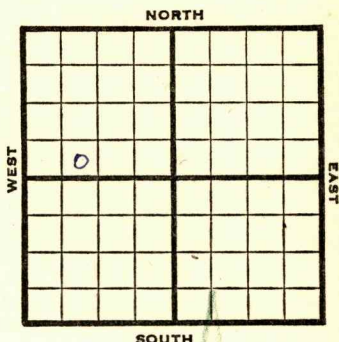

SE SW NW

REPORT

1946

6/19 Drlg 1200'
6/26 " "
7/3 Drlg 1750'
7/9 6" @ 1750'
Bart 1765
TD1820'
250 qts.
7/16 CO
7/24 Bart 1765
6" @ 1750
TD1820
Pump 50 Pot.
Grav. 38.0

COMPLETED

KANSASKansas Pool Name MiscellaneousMap No. 21 Sec. 6 Twp. 22 R. 12EWell No. 2 HensleyKeith Walker Company**FIRST REPORT**SE SW NW Contractor**SECTION PLAT**

 Ft. from N. Line330 Ft. from S. Line Ft. from E. Line990 Ft. from W. LineGreenwood CountyLocation Rig up

Drilling and Remarks:

1200'**RECORD**Cased in., ft.Sand Gas Oil Total Depth **PRODUCTION**1st 24 hrs. Nat. 1st 24 hrs. after shot Gas Cu. Ft.Dry Hole Abandoned

Date

JUN 19 194619S. J. LEWIS

Scout

KANSAS


Kansas

Pool Name MiscellaneousMap No. 21 Sec. 6 Twp. 22 R. 12EWell No. 2 HensleyKeith Walker Company**COMPLETED**

Contractor

SE SW NW

SECTION PLAT

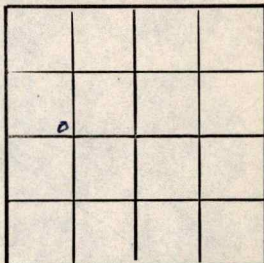 Ft. from N. Line330 Ft. from S. Line Ft. from E. Line990 Ft. from W. LineGreenwood CountyLocation Rig up

Drilling and Remarks:

*Bar 71765**6" C 1750**Pump 50 Pst**38" - 1/2"*

RECORD

Cased in., ft.Sand Gas Oil Total Depth 1820

PRODUCTION

1st 24 hrs. Nat. 1st 24 hrs. after shot Gas Cu. Ft.Dry Hole Abandoned

Date

JUL 24 1946 19S. J. LEWIS Scout