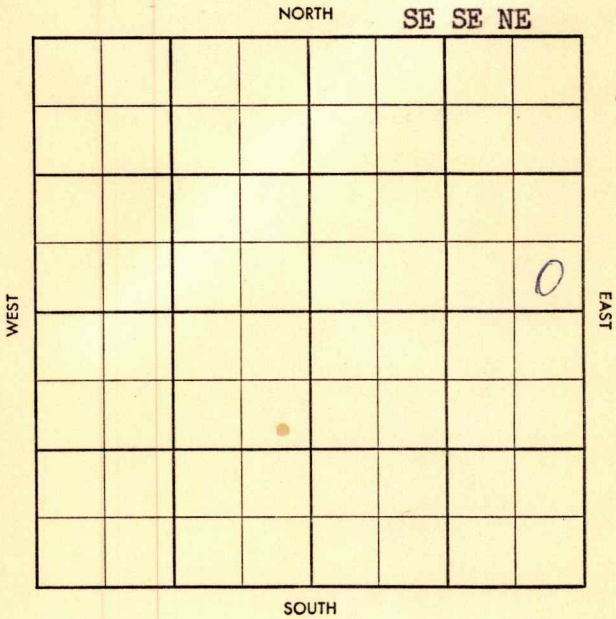


SECTION 6 TOWNSHIP 22S RANGE 12EWELL NO. #1 Jones SISTERSCOMPANY H. L. Ellis

County Greenwood Elev. _____
 Sec. 6 Twp. 22 Rge. 12E
 Company H. L. Ellis
 Farm Name Jones No. 1

TOPS	DEPTH	LOG	DATUM
Anh.			
Tp.			
H.			
Tr.			
Dg.			
B.L.			
L.			
K.C.			
B.K.C.			
Ce.			
C.			
M.			
M.			
K.			
Mz.			
Mq.			
V.			
S.			
S.			
A.			
R.			
Pf.			
G.			
T.D.			

Loc. in Sec. _____

SE SE NE

Geol. _____

Contr. _____

Eureka

Pool _____

APR 16 1958
FIRST REPORT

Date Comm. 4-15-58No. _____
Sec. _____
T. _____

Twp. ~~1~~ Pool ~~1~~
 Co. ~~1~~ Facet ~~1~~

S-513-B

County Greenwood Elev. _____
 Sec. 6 Twp. 22 Rge. 12E
 Company H. L. Ellis
 Farm Name Jones sisters No. 1

TOPS	DEPTH	LOG	DATUM	Loc. in Sec.
Anh.				SE SE NE
Tp.				
H.				
Tr.				
Dg.				
B.L.				
L.				
K.C.	<u>1858-77</u>			Geol.
B.K.C.				Contr.
Ce.				<u>Eureka</u>
C.				Pool
M.				
M.				
K.				
Mz.				
Mq.				
V.				
S.				
S.				
A.				
R.				
Pf.				
G.				
T.D.	<u>1879</u>			

Date Comm. 4-15-58
 APR 23 7" 225 cid 1858-79
rec 19' 50" 2' 50" 4" 1862 wolt
1830 50 CO 1879 7u 50' oil
tr. into 12hr. PB 1876 frac
7/ load MAY 7 '58 P 35 + trw
Best 1862-79