


Map No. 144 Sec. 6 Twp. 22 R. 11

Well No. 1 Fredrick Farm.

Connell et al Company

NORTH

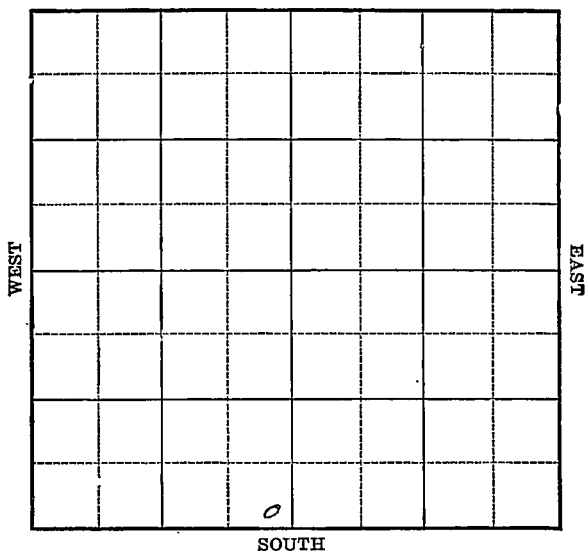

Location _____

Drilling Remarks

Rig Up_____

Drilling Remarks

RECORD

Cased_____in. _____ft.

Sand

Gas

Oil

Total Depth_____

PRODUCTION

1st 24 hrs. Nat. _____

1st. 24 hrs. after shot_____

Gas_____cu. ft.

Dry Hole_____


Abandoned _____

Map No. _____ Sec. 6 Twp. 22 R. 11Well No. 1 Fredrick FarmConnell et al Company

_____ Ft. from N. Line

200 Ft. from S. Line200 Ft. from E. Line

_____ Ft. from W. Line

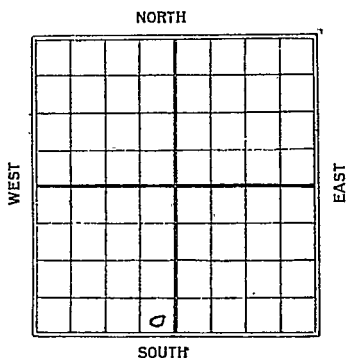

C.

Date
1925

REPORT

3/1 Location5/29 Top Line 2019 S. D. 2215
Water6/5 T.L. 3019 ID & Abd. 2120 H.F.W.

Map No. 2110 Sec. 6 Twp. 22 R. 11Well No. 1 FrederickCornell et al Company

Contractor

FIRST REPORT

_____ Ft. from N. Line

200 Ft. from S. Line200 Ft. from E. Line

_____ Ft. from W. Line

SECTION PLAT

Location ✓✓Rig up ✓

Drilling and Remarks:

RECORD

Cased _____ in., _____ ft.

Sand _____

Gas _____

Oil _____

Total Depth _____

PRODUCTION

1st 24 hrs. Nat. _____

1st 24 hrs. after shot _____

Gas _____ Cu. Ft.

Dry Hole _____

Abandoned _____

Date

3/1 1925M. A. BENNETT Scout

Map No. 15440 Sec. 6 Twp. 22 R. 11Well No. 1 MadisonConnell J ad Company

Contractor

COMPLETED

SECTION PLAT

Ft. from N. Line

200 Ft. from S. Line200 Ft. from E. Line

Ft. from W. Line

ABANDONED

Location

Rig up

Drilling and Remarks:

top line 2019'Dry 2 pho20 2120' 1/2"

RECORD

Cased _____ in., _____ ft.

Sand _____

Gas _____

Oil _____

Total Depth 2120'

PRODUCTION

1st 24 hrs. Nat. _____

1st 24 hrs. after shot _____

Gas _____ Cu. Ft.

Dry Hole ☒Abandoned ☒

Date

JUN 5 1925

192

CHAS. L. SHERWOOD

Scout