
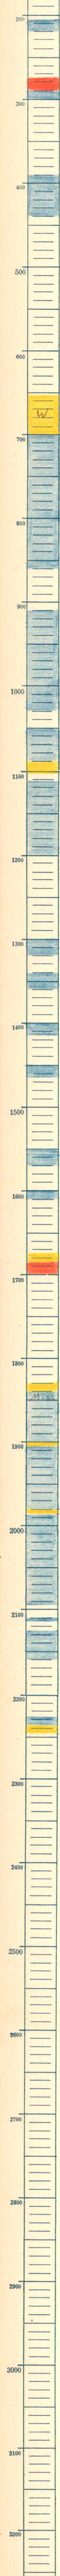


Twp. S. 7 T. 22 S., R. 13 E.  
 Greenwood County  
 Company  
 Jacob Ott #1 Farm  
 ev. 1197 T.D. 2246  
 Correlation by  
 Date drilled

 

W  
 75  
 85  
 00  
 80  
 40  
 Miss  
 1400  
 5  
 30  
 25  
 10-15  
 25  
 60  
 26  
 36  
 T.D. 2246