
Form 51 5M 7-22 9573

Kansas V

Map No. _____ Sec. 7 Twp. 22 R. 10

Well No. 1 Pindle Farm

Phillips Pet. Company

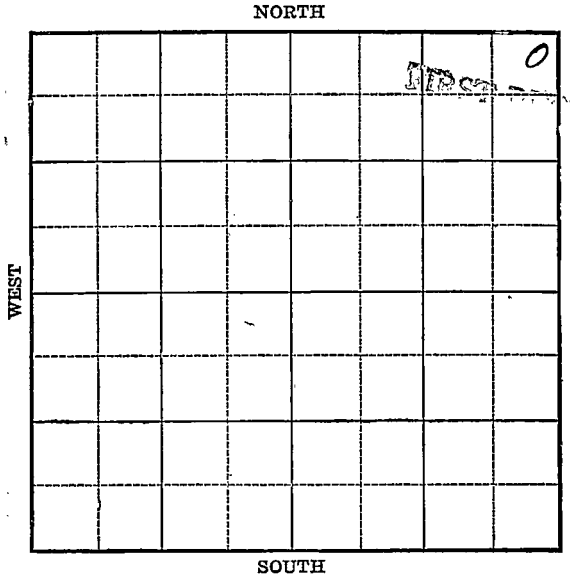

Location _____

Drilling Remarks:

Rig up _____

Drilling Remarks:

RECORD

Cased _____ in. _____ ft.

Sand _____

Gas _____

Oil _____

Total Depth _____

PRODUCTION

1st 24 hrs Nat. _____

1st 24 hrs. after shot _____

Gas _____ cu. ft.

Dry Hole _____

Abandoned _____

Form 252A 8M-11-20 PALACE-TULSA 4617 Kansas

Map No. _____ Sec. 7 Twp. 22 R. 10

Well No. 1 Ripley Farm


Phillips Pet. Company

250 Ft. from N. Line

_____ Ft. from S. Line

250 Ft. from E. Line

_____ Ft. from W. Line

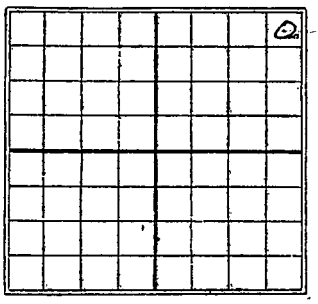

Date	REPORT
1922	
12/30	Rig & tools.
1923	
2/24	D. & C. 2519'

Form 26—1M—4-19—Mid-West


Map No. KN Sec. 7 Twp. 22 R. 10

Well No. 1 Pickle,

Phillips Pet Company

Contractor

SECTION PLAT

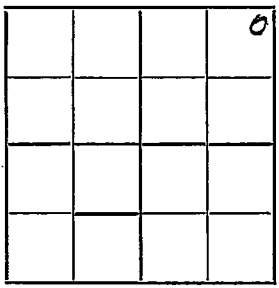

250 Ft. from N. Line

Ft. from S. Line

250 Ft. from E. Line

Ft. from W. Line

FIRST REPORT

Location

Rig up

Drilling and Remarks:

Rig + Tools

RECORD

Cased in., ft.

Sand

Gas

Oil

Total Depth

PRODUCTION

1st 24 hrs. Nat.

1st 24 hrs. after shot

Gas Cu. Ft.

Dry Hole

Abandoned

Date

12/20/22 191

Scout

Form 26—1M—4-19—Mid-West

Map No. KANSAS Sec. 7 Twp. 22 R. 16


Well No. 1 Pixley

P Phillips Company

Contractor

FIRST REPORT

SECTION PLAT

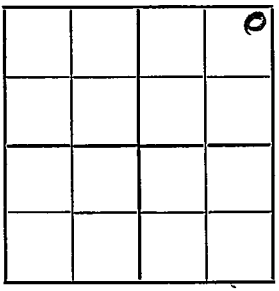

250 Ft. from N. Line

Ft. from S. Line

250 Ft. from E. Line

Ft. from W. Line

Location

Rig up

Drilling and Remarks:

Rig to Tools

RECORD

Cased in., ft.

Sand

Gas

Oil

Total Depth

PRODUCTION

1st 24 hrs. Nat.

1st 24 hrs. after shot

Gas Cu. Ft.

Dry Hole

Abandoned

Date

JAN 6 1923

191

M. A. BENEAR

Scout

Form 26—1M—4-19—Mid-West

Map No. KANSAS 21 Sec. 7 Twp. 22 R. 10


Well No. 1 Linder

Phillips Pet. Company

Contractor

ABANDONED

SECTION PLAT

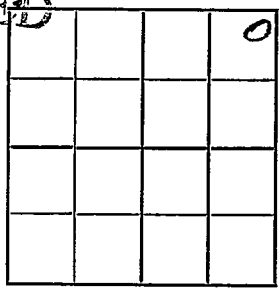

250 Ft. from N. Line

Ft. from S. Line

250 Ft. from E. Line

Ft. from W. Line

Location

Rig up

Drilling and Remarks:

Sand 2322-2333

Top Lime 2446'

RECORD

Cased in., ft.

Sand

Gas

Oil

Total Depth

PRODUCTION

1st 24 hrs. Nat.

1st 24 hrs. after shot

Gas Cu. Ft.

Dry Hole 2519

Abandoned

Date

FEB 24 1923

191

M. A. BENEAR

Scout