


Map No. 4-Exilee Sec. 1 Twp. 22 R. 10
Well No. Wm Moore Oil & Gas Farm _____
Company _____

NORTH

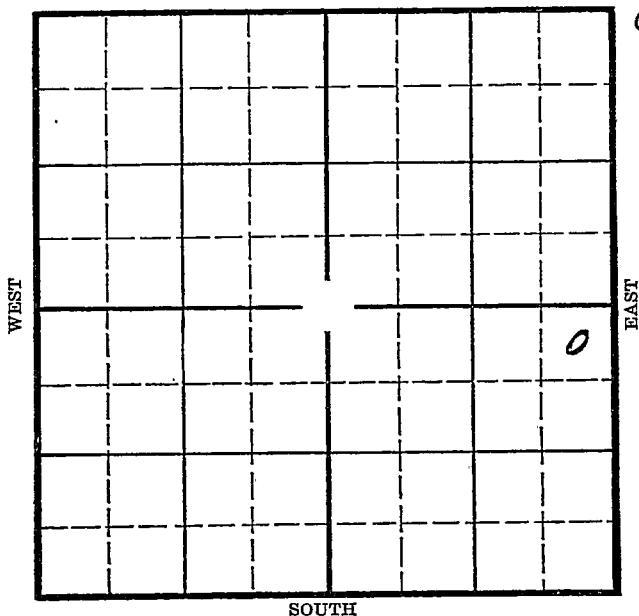

Rig Up_____

Drilling Remarks

PRODUCTION

1st 24 hrs. Nat. _____

1st 24 hrs. after shot _____

Gas _____ cu. ft. _____

Dry Hole _____

Abandoned _____

5M 7-35 MPC
Map No. _____ **KANSAS** _____ S

Map No. 10 Sec. 1 Twp. 22 R. 10

Well No. 4 - Piller Farm 1

Well No. 1 Wm. Moore Oil & Gas Company

330 Ft. from N. Line

_____ Ft. from S. Line

330 Ft. from E. Line

Ft. from W. Line

NORTH

A blank 10x10 grid for drawing.

SOUTH

Date /

REPORT

1/30 Machine
 1/17 Rgn pup
 1/24 Spent
 1/31 Wly 525
 2/7 " 1065
 2/14 " 1460
 2/21 " 1670
 2/28 " 1900 8" 1845
 3/6 Part 2294 Wly 2313
 600 OTH
 3/18 Part 2294
 TD 2338
 Shot 60 gts
 Swab 200 Bbls.

COMPLETED

Map No. 21 Sec. 7 Twp. 22 R. 10E

Well No. 4 - Piller

Wm Moore Oil & Gas Company

.....Contractor

SECTION PLAT

330 Ft. from N. Line

.....Ft. from S. Line

330 Ft. from E. Line

.....Ft. from W. Line

			0

FIRST REPORT

Location.....

Rig up.....

Drilling and Remarks:

machine

RECORD

Cased.....in.,ft.

Sand.....

Gas.....

Oil.....

Total Depth.....

PRODUCTION

1st 24 hrs. Nat.....

1st 24 hrs. after shot.....

Gas.....Cu. Ft.

Dry Hole.....

Abandoned.....

Date

JAN 8 1936₁₉₂

ORVAL MANNSCHRECK

Scout

Map No. 21 Sec. 7 Twp. 22 R. 10E

Well No. 4 - Pisslee

Moore O & G Company

Contractor

COMPLETED

SECTION PLAT

330 Ft. from N. Line

..... Ft. from S. Line

330 Ft. from E. Line

..... Ft. from W. Line

			0

Location.....

Rig up.....

Drilling and Remarks:

shot w/60 gts

Sub. 200 hbls

RECORD

Cased..... in., ft.

Sand Bart 2294

Gas.....

Oil.....

Total Depth 2338

PRODUCTION

1st 24 hrs. Nat.....

1st 24 hrs. after shot.....

Gas..... Cu. Ft.

Dry Hole.....

Abandoned.....

Date

MAR 18 1936₁₉₂

ORVAL MANNSCHRECK

Scout