


SECTION 7 TOWNSHIP 22S RANGE 12E

WELL NO. #1 Harlan

COMPANY M. G. Wilson

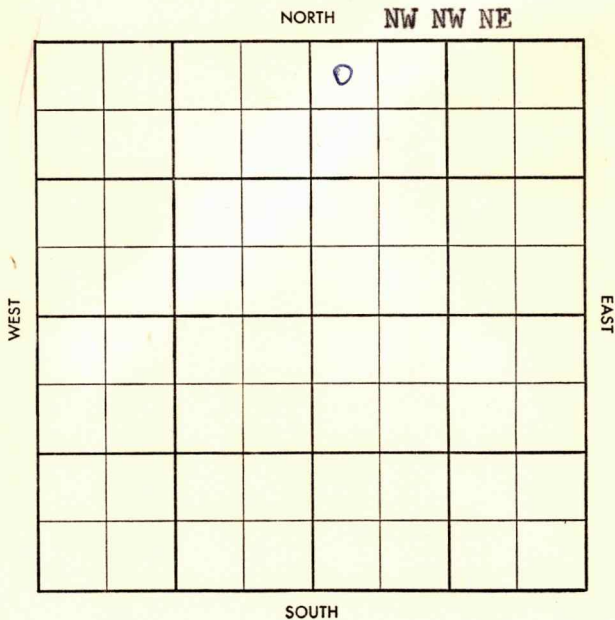

~~Top~~ ~~Pool~~

~~Co.~~ ~~Facot.~~

S-513-B

County Greenwood Elev. _____
 Sec. 7 Twp. 22 Rge. 12E
 Company M. G. Wilson
 Farm Name Harlan No. 1

TOPS	DEPTH	LOG	DATUM
Anh.			
Tp.			
H.			
Tr.			
Dg.			
B.L.			
L.			
K.C.			
B.K.C.			
Ce.			
xxx Btvl Sd	1735		
M.			
M.			
K.			
Mz.			
Mq.			
V.			
S.			
S.			
A.			
R.			
Pf.			
G.			
T.D.			

Loc. in Sec. _____
App NW NW NE
190' fwl x
320' fnl NE
 Geol. _____
 Contr. _____
V. Baker
 Pool _____
Madison

JUL 16 1958
 FIRST REPORT

Date Comm. 6-13-58
8" @ 120, Core 1737-61 full rec. good show
TD 1761, 4" @ 1735, CO 1761 frac to POP

Co.
 No.
 Sec.
 T.
 R.

Twp. 7 Root No
 Co. No Facet No


MU 49035

S-513:B

County Greenwood Elev. _____
 Sec. 7 Twp. 22 Rge. 12E
 Company M. G. Wilson (Wichita)
 Farm Name Harlan No. I

TOPS	DEPTH	LOG	DATUM
Anh.			
Tp.			
H.			
Tr.			
Dg.			
B.L.			
L.			
K.C.			
B.K.C.			
Ce.			
xx Elev Sd	1735		
M.			
M.			
K.			
Mz.			
Mq.			
V.			
S.			
S.			
A.			
R.			
Pf.			
G.			
T.D.			

Loc. in Sec. _____
 App NW NE
190' [w] x
320' [n] NE
 Geol. _____
 Contr. V. Baker
 Pool Madison

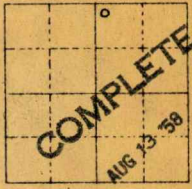

Date Comm. 6-13-58

8" @ 120, Core 1737-61 full rec. good show
ID 1761, 4" @ 1735, CO 1761 frac to POP
JUL 23 '58 JUL 30 '58 AUG 6 '58 AUG 13 '58 P 153

Bopp + 6 BW pd

Co. No. Sec. T. R.