

Map No.

Sec.

Twp.

R.

Well No.

Farm

Company

NORTH

WEST

EAST

SOUTH

Location

Drilling Remarks:

Rig Up

Drilling Remarks:

RECORD

Cased _____ in. _____ ft.

Sand

Gas

Oil.

Total Depth

PRODUCTION

1st 24 hrs. Nat.

1st 24 hrs. after shot

Gas _____ cu. ft.

Dry Hole

Abandoned

Map No. K Sec. 7 Twp. 22 R. 12


Well No. 1 Farm Elrod et al Company

200 Ft. from N. Line

_____ Ft. from S. Line

11 W Ft. from E. Line

_____ Ft. from W. Line

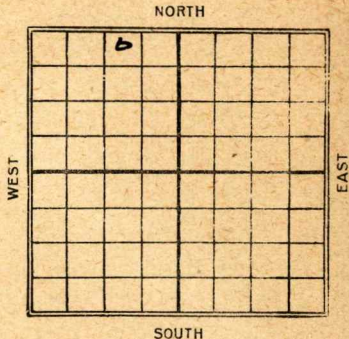

Date
1941
6/24
8/6

REPORT

Regru rep
D. & G. 1940'

21 **KANSAS** Map No. _____ Sec. 7 Twp. 22 R. 12

Well No. 1 _____

E. Brad et al _____ Company

_____ Contractor

FIRST REPORT**SECTION PLAT**

200 Ft. from N. Line

_____ Ft. from S. Line

1120 Ft. from E. Line

_____ Ft. from W. Line

	0		

Location _____

Rig up _____

Drilling and Remarks:

Rig up

RECORD

Cased _____ in., _____ ft.

Sand _____

Gas _____

Oil _____

Total Depth _____

PRODUCTION

1st 24 hrs. Nat. _____

1st 24 hrs. after shot _____

Gas _____ Cu. Ft.

Dry Hole _____

Abandoned _____

Date

JUN 24 1924

M. A. BENEAR

192

Scout

Map No. **KANSAS** ²¹ Sec. **7** Twp. **22** R. **12**Well No. **1** **Calroad**
Calroad et al Company

Contractor

ABANDONED SECTION PLAT**200** Ft. from N. Line

Ft. from S. Line

1120 Ft. from E. Line

Ft. from W. Line

	0		

Location

Rig up

Drilling and Remarks:

LQ+9
1940**RECORD**

Cased _____ in., _____ ft.

Sand _____

Gas _____

Oil _____

Total Depth _____

PRODUCTION

1st 24 hrs. Nat. _____

1st 24 hrs. after shot _____

Gas _____ Cu. Ft.

Dry Hole _____

Abandoned _____

Date

AUG 6 1924**192****M. A. BENEAR**

Sc

Twp. Pool

O.W.W.O. Co. Facet

S-513.B

County Greenwood Elev.
Sec. 7 Twp. 22 Rge. 12E
Company Shepard & Wilson (was Elrod)
Farm Name Huber (Was #1 Elrod) 1

TOPS	DEPTH	LOG	DATUM
Anh.			
Tp.			
H.			
Tr.			
Dg.			
B.L.			
L.			
K.C.			
B.K.C.			
Ce. <u>Bart.</u>	<u>1806</u>		
C.			
M. <u>B+1</u>	<u>1798-1822</u>		
M.			
K.			
Mz.			
Mq.			
V.			
S.			
S.			
A.			
R.			
Pf.			
G.			
T.D.			

Loc. in Sec. NW NE NW
O.W.O.
O.W.W.O.
Geol.
Contr. Vernon Baker
Pool Fankhouser

<u>p</u>		
	<u>JUN 11 '58</u>	
<u>ABANDONED</u>		

Date Comm. OTD 1940 CO @ 1800 MAY 7 '58 CO 1940
B+1/1798-1822 4' 1816
MAY 14 '58 MAY 21 '58 MAY 26 '58 CO 1850
from JUN 3 '58 p on Ld JUN 11 '58

T&A

~~Top~~ ~~Post~~
~~Change~~ ~~Post~~
O.W.W.O.

Co.

Lse

No.



1.

