


SECTION 7 TOWNSHIP 22S RANGE 12E

WELL NO. #1 James

COMPANY Vernon Baker

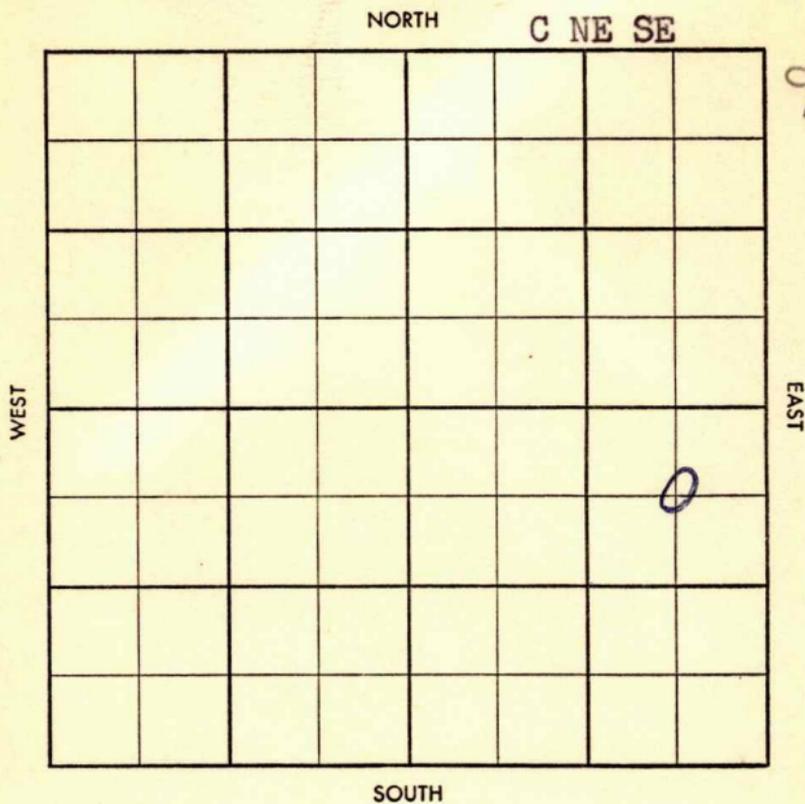

~~Twp. Pool~~
~~Ce. Foot~~

S-513-B

County Greenwood Elev. _____
Sec. 7 Twp. 22 Rge. 12E
Company Vernon Baker
Farm Name James No. 1

TOPS	DEPTH	LOG	DATUM
Anh.			
Tp.			
H.			
Tr.			
Dg.			
B.L.			
L.			
K.C.			
B.K.C.			
Ce.			
C.			
M.			
M.			
K.			
Mz.			
Mq.			
V.			
S.			
S.			
A.			
R.			
Pf.			
G.			
T.D.			

Loc. in Sec. _____
C NE SE
Geol. _____
Contr. _____
Baker Drlg.
Pool _____
Fankhouser



Date Comm. _____

MIRT

Co.
Lse.
No.
Sec.
T.
R.

~~Twp. Pool~~

~~Co. Facet~~

S-513-B

County Greenwood Elev. _____
 Sec. 7 Twp. 22 Rge. 12E
 Company Vernon Baker
 Farm Name James No. 1

TOPS	DEPTH	LOG	DATUM
Anh.			
Tp.			
H.			
Tr.			
Dg.			
B.L.			
L.			
K.C.			
B.K.C.			
Ce.			
C.			
M. <u>B7V1</u>	<u>1785-87</u>		
M.	<u>1920</u>		
K.			
Mz.			
Mq.			
V.			
S.			
S.			
A.			
R.			
Pf.			
G.			
T.D.	<u>1930</u>		

Loc. in Sec. _____

C NE SE

Geol. _____

Contr. _____

Baker Drlg.

Pool _____

Fankhouser

ABANDONED

JUN 11 '58

0

Date Comm. 6-4-58 8"235

MIRT 11 '58

DOA