


Greenwood

KANSAS

SECTION 7 TOWNSHIP 22S RANGE 12E

WELL NO. #1 Kipfer

COMPANY Gross Producing

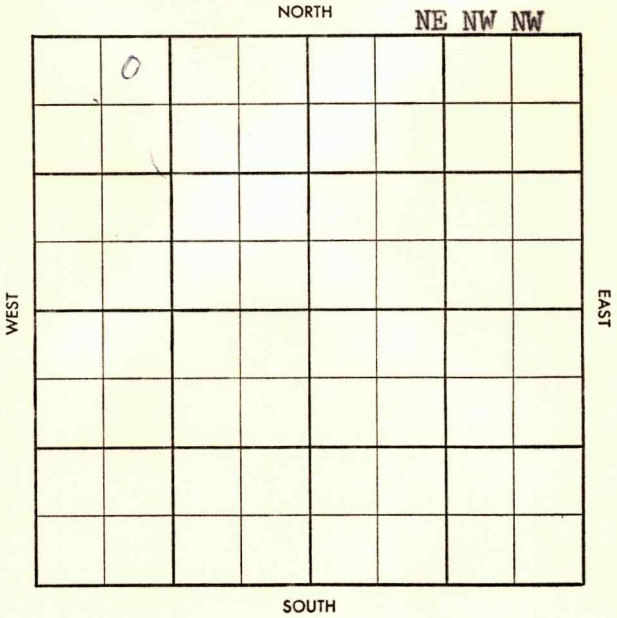

Twp. ~~22~~ Pool ~~12E~~

Co. ~~22~~ Facet ~~12E~~

S-513-B

County Greenwood Elev. _____
 Sec. 7 Twp. 22 Rge. 12E
 Company Gross Producing
 Farm Name Kipfer No. 1

| TOPS | DEPTH | LOG | DATUM |
|--------------------|---------|-----|-------|
| Anh. | | | |
| xx Btvl | 1841-69 | | |
| H. | | | |
| Tr. | | | |
| Dg. | | | |
| B.L. | | | |
| L. | | | |
| K.C. | | | |
| B.K.C. | | | |
| Ce. | | | |
| C. | | | |
| M. | | | |
| M. | | | |
| K. | | | |
| Mz. | | | |
| Mq. | | | |
| V. | | | |
| S. | | | |
| S. | | | |
| A. | | | |
| R. | | | |
| Pf. | | | |
| G. | | | |
| T.D. | | | |

Loc. in Sec. _____
NE NW NW
 Geol. _____
 Contr. _____
H & C Drilg.
 Pool _____
Madison



Date Comm. 7-2p58
8" @ 108 w/85, core 1851-72 full rec. SO 5"
@ 1890, 1890 TD, WOCT

Co.
 Lse.
 No.
 Sec.
 T.
 R.

Twp. Pool
 Co. Facet


County Greenwood Elev.
 Sec. 7 Twp. 22 Rge. 12E
 Company Gross Producing
 Farm Name Kipfer No. 1

| TOPS | DEPTH | LOG | DATUM |
|----------------------|-------------|-----|-------|
| Arh. | | | |
| Arh. Btvl | 1841-69 | | |
| H. | | | |
| Tr. | | | |
| Dg. | | | |
| B.L. | | | |
| L. | | | |
| K.C. | | | |
| B.K.C. | | | |
| Ce. | | | |
| C. | | | |
| M. | | | |
| M. | | | |
| K. | | | |
| Mz. | | | |
| Mq. | | | |
| V. | | | |
| S. | | | |
| S. | | | |
| A. | | | |
| R. | | | |
| Pf. | | | |
| G. | | | |
| T.D. | <u>1890</u> | | |

Loc. in Sec. NE NW NW
 Geol.
 Contr.
H & C Drlg.
 Pool
Madison

| | |
|-----------------|---|
| . | . |
| COMPLETE | |
| AUG 6 '58 | |

Date Comm. 7-29-58
8" @ 108 w/85, core 1851-72 full rec. 80 5"
@ 1890, 1890 TD, WOCT JUL 16 '58 WOCT
JUL 23 '58 CO 72/1842-60 20/1866-71
Kipfer frac co JUL 30 '58
AUG 6 '58 P 68 BOPD + 17 BWPD
Part 1842-71

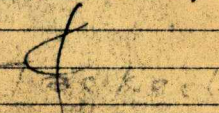
 J. S. Kipfer