


Section 8 Township 22 Range 2-E

Well Number #1 Guthrie

Company Sacco Oil

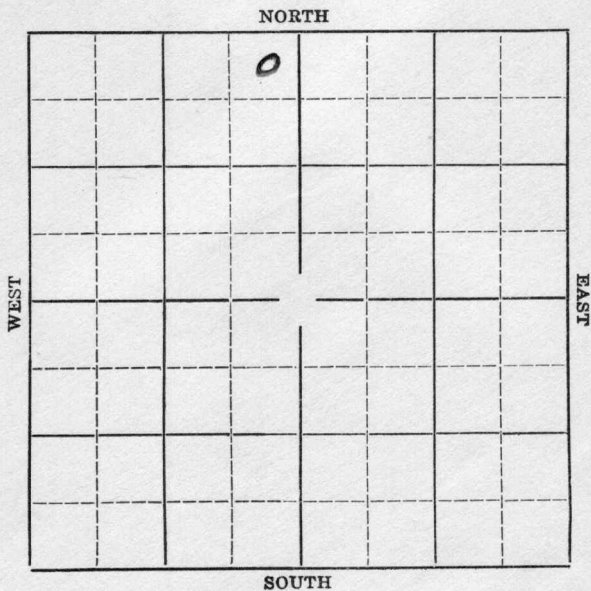


Sec. 8 Twp. 22 R. 2EWell No. #1 Guthrie FarmSacco Oil Company330' Ft. from N. Line

Ft. from S. Line

330' Ft. from E. Line

Ft. from W. Line

Elev. 1502

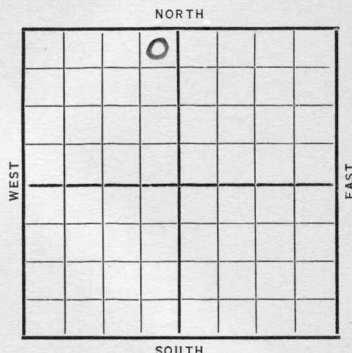

Date	REPORT
10/21	Rig and tools.
10/29	Spud.
11/6---	
11/12	15" @ 451 Drlg. 670
11/19	12½" @ 1215'. Drlg. 1225'.
11/27	10" @ 1993'. Drlg. 2000'.
12/3	2090'. Rebuilding rig.
12/10	10" @ 2243'. 2374 Underream 10"
12/17	Lansine 2187'. 10" @ 2418'.
	Drlg. 2465'.
12/24	Drlg. 2765'.
12/29	Chat 2843'. 2845 H. F. W.
	Underream 8".
1937	
1/7	8" @ 2925'. Drlg. 2975'.
1/14	Base Miss L. 3060'.
	Hunton 3065'. Drlg. 3200'.
1/22	Wilcox 3315'. Sil. 3350'.
	T. D. 3486'. Shut down.
	OVER

1/27 --Sil. 3388 Corrected

T. D. 3485

D & A

ABANDONED

KANSAS

Map No. 24 Sec. 8 Twp. 22 R. 2EWell No. 1 GutherSacco Oil Company

Contractor

SECTION PLAT

		0		

320 Ft. from N. Line

_____ Ft. from S. Line

330 Ft. from E. Line

_____ Ft. from W. Line

FIRST REPORT

Location _____

Rig up _____

Drilling and Remarks:

Rig too late

RECORD

Cased _____ in., _____ ft.

Sand _____

Gas _____

Oil _____

Total Depth _____

PRODUCTION

1st 24 hrs. Nat. _____

1st 24 hrs. after shot _____

Gas _____ Cu. Ft.

Dry Hole _____

Abandoned _____

Date

OCT 21 1936

19

S. J. LEWIS

Scout

Returned _____

Cards _____

Tracing _____

France Map _____

Scarborough Map _____

Moody Map _____

Scarborough Plat Book _____

Moody Plat Book _____

KANSAS

Map No. 24 Sec. 8 Twp. 22 R. 2EWell No. 1 GuthrieSacco Oil Company

Contractor

SECTION PLAT

		<u>0</u>	

330 Ft. from N. Line

_____ Ft. from S. Line

330 Ft. from E. Line

_____ Ft. from W. Line

ABANDONED

Location _____

Rig up _____

Drilling and Remarks:

Oil 3388'
CorrectedNYA

RECORD

Cased _____ in., _____ ft.

Sand _____

Gas _____

Oil _____

Total Depth 3485

PRODUCTION

1st 24 hrs. Nat. _____

1st 24 hrs. after shot _____

Gas _____ Cu. Ft.

Dry Hole _____

Abandoned _____

Date

JAN 27 1937 19

S. J. LEWIS

Scout

SECTION PLAT

Handwritten signature

Handwritten signature

PRODUCTION

Cards *Paul*

Tracing *Joe*

Francis *MS*

Seamwork

Moody Map

Seaborough Plat Book

Moody Plat Book