


Map No. KANSAS Sec. 8 Twp. 22 R. 3 4EWell No. 2 - Spirit FarmJohn Markham Company

NORTH

WEST

EAST

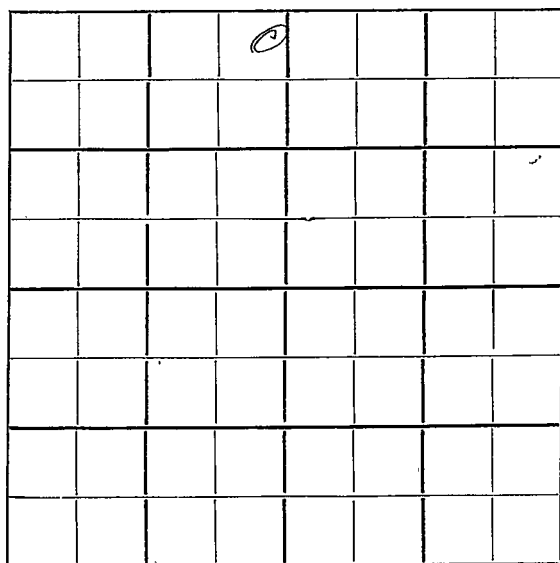

SOUTH

3

Location.....

Drilling Remarks

Rig Up.....

Drilling Remarks

## RECORD

Cased.....in.....ft.

Sand.....

Gas.....

Oil.....

Total Depth.....

## PRODUCTION

1st 24 hrs. Nat.....

1st 24 hrs. after shot.....

Gas.....cu. ft.....

Dry Hole.....

Abandoned.....

Map No. .... Sec. .... Twp. .... R. ....

Well No. .... Farm


..... Company

..... Ft. from N. Line

..... Ft. from S. Line

..... Ft. from E. Line

..... Ft. from W. Line

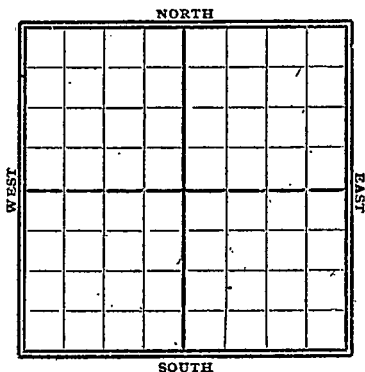

1924

Date

REPORT

*Gypsy Records*

8/19

*Abd TD 2542'*

MAP No. \_\_\_\_\_ SEC. 8 TWP. 27S R. 4EWELL No. 2 SpecJohn Markham COMPANY

CONTRACTOR

## SECTION PLAT

	0		

\_\_\_\_\_ FT. FROM N. LINE

\_\_\_\_\_ FT. FROM S. LINE

\_\_\_\_\_ FT. FROM E. LINE

\_\_\_\_\_ FT. FROM W. LINE

no more

## RECORD

LOCATION \_\_\_\_\_

CASED \_\_\_\_\_ IN. \_\_\_\_\_ FT.

RIG UP \_\_\_\_\_

SAND \_\_\_\_\_

DRILLING AND REMARKS:

GAS \_\_\_\_\_

OIL \_\_\_\_\_

TOTAL DEPTH 254 1/2

## PRODUCTION

1ST 24 HRS. NAT. \_\_\_\_\_

1ST 24 HRS. AFTER SHOT \_\_\_\_\_

GAS \_\_\_\_\_ CU. FT.

DRY HOLE ☒ABANDONED ☒

DATE

8/19 192 4 SCOUT