


DX 78-1 Marion

**KANSAS**

Section 8 Township 22 Range 4E

Well No. #1 Beith-Spier

Company Beaumont-Petroleum

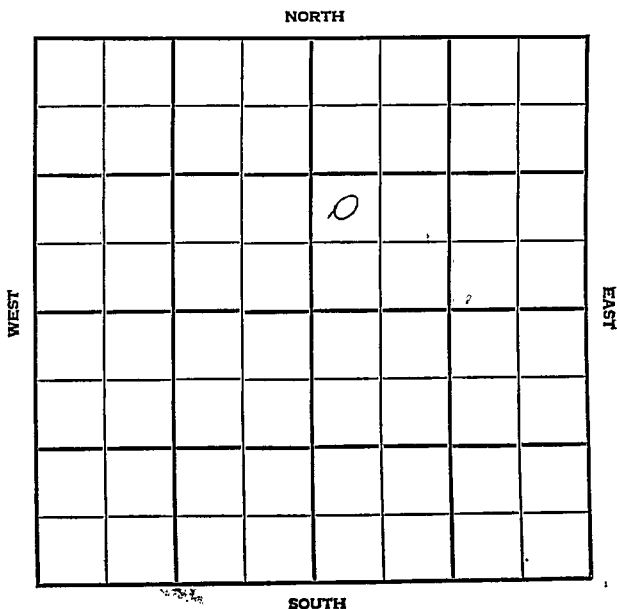

7

Marion

KANSAS

SEC. 8	TWP. - - -22-	R. 1E
-----------	------------------	----------

WELL NO. #1 Beity-Spier FARM

COMPANY  
Beaumont Petroleum

CONTRACTOR  
Co. Tools

Peabody

\_\_\_\_\_ FT. FROM N. LINE

\_\_\_\_\_ FT. FROM S. LINE

\_\_\_\_\_ FT. FROM E. LINE

\_\_\_\_\_ FT. FROM W. LINE

NW SW NE

NORTH				
			o	
WEST				EAST
SOUTH				

1956	ELEVATION 1423'	REPORT
------	--------------------	--------

8-15 MIR

8-29 Comm. 8-18-56  
8 5/8" @ 126  
DST 2352-62 op 1 hr., rec. 3' mud,  
BHP 450#.  
No log.  
D&A  
L. 1850'; BKC 2213'; Marm 2265';  
Cg. 2343'; M. 2351'; M.Li. 2392';  
K. 2415';  
TD 2429

**ABANDONED**

County Macon Elev. \_\_\_\_\_  
 Sec. 8 Twp. 22 Rge. 1E  
 Company Beaumont Petroleum  
 Farm Name Beity-Spier No. 1

TOPS	DEPTH	LOG	DATUM
Anh.			
Tp.			
H.			
Tr.			
Dg.			
Bl.			
L.			
K.C.			
B.K.C.			
Ce.			
C.			
M.			
M.			
K.			
Mz.			
Mq.			
V.			
S.			
S.			
A.			
R.			
Pe.			
G.			
T.D.			

Loc. in Sec. \_\_\_\_\_

NW SW NE

Geol. \_\_\_\_\_

Contr. \_\_\_\_\_

Co. tools

Pool \_\_\_\_\_

Peabody


**FIRST REPORT**  
AUG 15 '56

Date Comm. M I R

W. S. S. DUA

~~125~~

Co.

Use.

No.

Sec.

T.

R.

County Marion Elev. 1123  
 Sec. 8 Twp. 22 Rge. 4E  
 Company Beaumont Petroleum  
 Farm Name Beity-Spier No. 1

TOPS	DEPTH	LOG	DATUM	Loc. in Sec.
Anh.				NW SW NE
Tr.				
H.				
Tr.				
Dg.				
Bl.				
L.	1850			Geol.
K.C.				Contr.
B.K.C.	2213			Co. tools
Ce.	Marm 2265			
G.	cg 2343			
M.	2351			Pool
M.	L1 2392			Peabody
K.	2415			
Mz.				
Mq.				
V.				
S.				
S.				
A.				
R.				
PE.				
G.				
T.D.	2429			ABANDONED

Date Comm. AUG 29 1956

M I R AUG 22 '58 R-18-56 8578126

D 1600 AUG 29 '58 DST 2352-62

1hr 3' Md BHP 450

no log

DEQ

Co.  
Lse.  
No.  
Sec.  
T.  
R.