

Map No. Sec. Twp. R.

Well No. Farm


..... Company

..... Ft. from N. Line

..... Ft. from S. Line

..... Ft. from E. Line

..... Ft. from W. Line

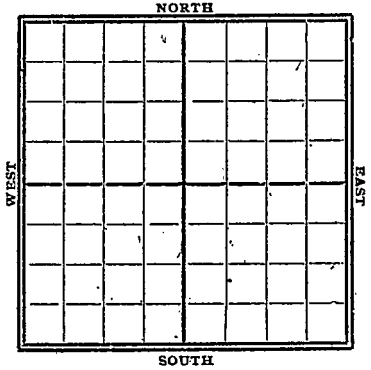

1924

Date

REPORT

Gypsy Records

2/20

Abel T D 2550'

MAP No. _____ SEC. 8 TWP. 27S R. 4E

WELL No. _____

Kansol Oil Corp COMPANY

CONTRACTOR _____

SECTION PLAT

		0	

_____ FT. FROM N. LINE

_____ FT. FROM S. LINE

_____ FT. FROM E. LINE

_____ FT. FROM W. LINE

no known

LOCATION _____

RIG UP _____

DRILLING AND REMARKS:

water in pits

RECORD

CASED _____ IN. _____ FT.

SAND _____

GAS _____

OIL _____

TOTAL DEPTH 7550

PRODUCTION

1ST 24 HRS. NAT. _____

1ST 24 HRS. AFTER SHOT _____

GAS _____ CU. FT.

DRY HOLE

ABANDONED

DATE

1/20 1924

SCOUT