


Marion Co

Map No. Kansas Sec. 8 Twp. 22 R. 4

Well No. 6 Speers Farm
John H. Markham Company

NORTH

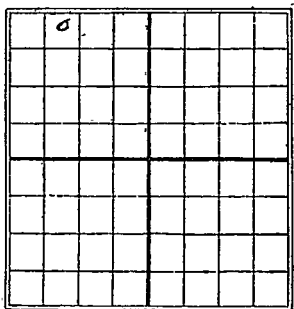

200 Ft. from N. Line

..... Ft. from S. Line

..... Ft. from E. Line

1120 Ft. from W. Line

SOUTH

Date
1925

REPORT

11/13 Running 10" at 1400 feet

12/3 Sho oil 2332-80

2499-2500 H.F.W

D. & A. 2500

Million 20

Map No. *K 23* KANSAS Sec. *8* Twp. *22* R. *4*

Well No. *6* *Speers*

John. H. Mankham Company

Contractor

FIRST REPORTS

SECTION PLAT

200 Ft. from N. Line
 _____ Ft. from S. Line
 _____ Ft. from E. Line
1120 Ft. from W. Line

0			

Location _____

Rig up _____

Drilling and Remarks:

*Running 10"
 at 1400'*

RECORD

Cased _____ in., _____ ft.
 Sand _____
 Gas _____
 Oil _____
 Total Depth _____

PRODUCTION

1st 24 hrs. Nat. _____
 1st 24 hrs. after shot _____
 Gas _____ Cu. Ft.
 Dry Hole _____
 Abandoned _____

Date

NOV 13 1925 CHAS. L. SHERWOOD

192 _____ Scout

MALLOW Co

Map No. KANSAS Sec. 8 Twp. 22 R. H

Well No. 6 Speers

John. H. Mankham Company

Contractor

COMPLETED

SECTION PLAT

200 Ft. from N. Line

_____ Ft. from S. Line

_____ Ft. from E. Line

1120 Ft. from W. Line

ABANDONED

6			

Location _____

Rig up _____

Drilling and Remarks:

Show oil 2322-80'
 NFW 2499-2500'
 Dry & sho
 L.D. 2500'

RECORD

Cased _____ in., _____ ft.

Sand _____

Gas _____

Oil _____

Total Depth 2500'

PRODUCTION

1st 24 hrs. Nat. _____

1st 24 hrs. after shot _____

Gas _____ Cu. Ft.

Dry Hole

Abandoned

Date

DEC 3 1925

192

CHAS. L. SHERWOOD

Scout

MAP NO. _____ SEC. 8 TWP. 27S R. 4E

WELL NO. 6 Acres

John Warshaw COMPANY

CONTRACTOR

SECTION PLAT

0			

_____ FT. FROM N. LINE

_____ FT. FROM S. LINE

_____ FT. FROM E. LINE

_____ FT. FROM W. LINE

LOCATION _____

RIG UP _____

DRILLING AND REMARKS:

277

RECORD

CASED _____ IN., _____ FT.

SAND _____

GAS _____

OIL _____

TOTAL DEPTH 7500

PRODUCTION

1ST 24 HRS. NAT. _____

1ST 24 HRS. AFTER SHOT _____

GAS _____ CU. FT.

DRY HOLE

ABANDONED

DATE

12/16 1925

SCOUT