

Kansas

Map No. _____ Sec. 8 Twp. 22 R. 10

Well No. 1 Pixlee _____ Farm

Wants Phillips _____ Company


NORTH

250 Ft. from N. Line

_____ Ft. from S. Line

_____ Ft. from E. Line

250 Ft. from W. Line

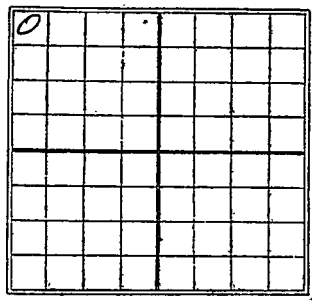

REPORT

Date
1922

12/30 Rgn up.

1923

3/2 Sand 2335-83 - Shot 100
pts. 65 BBS.

Map No. KVI Sec. 8 Twp. 22 R. 10

Well No. 1 Gilder

Waite Phillips Company

Contractor

SECTION PLAT

250 Ft. from N. Line

_____ Ft. from S. Line

_____ Ft. from E. Line

250 Ft. from W. Line

0			

FIRST REPORT

Location _____

Rig up _____

Drilling and Remarks:

Rig up

RECORD

Cased _____ in., _____ ft.

Sand _____

Gas _____

Oil _____

Total Depth _____

PRODUCTION

1st 24 hrs. Nat. _____

1st 24 hrs. after shot _____

Gas _____ Cu. Ft.

Dry Hole _____

Abandoned _____

Date

12/30/22 191_____

Scout

Map No. **KANSAS.** Sec. **8** Twp. **22** R. **10**
 Well No. **1 Pipler**
Wahato P. Mills Company
 Contractor

FIRST REPORT

250 Ft. from N. Line
 ----- Ft. from S. Line
 ----- Ft. from E. Line
250 Ft. from W. Line

SECTION PLAT

0.			

Location -----

Rig up -----

Drilling and Remarks:

Rig up

RECORD

Cased ----- in., ----- ft.
 Sand -----
 Gas -----
 Oil -----
 Total Depth -----

PRODUCTION

1st 24 hrs. Nat. -----
 1st 24 hrs. after shot -----
 Gas ----- Cu. Ft.
 Dry Hole -----
 Abandoned -----

Date

JAN 6 1923

M. A. BENEAR

Map No. **KANSAS** 21 Sec. 8 Twp. 22 R. 10

Well No. 1 *Pixlee*
Waite Phillips Company

Contractor

COMPLETED SECTION PLAT

250 Ft. from N. Line

----- Ft. from S. Line

----- Ft. from E. Line

250 Ft. from W. Line

0			

Location -----

Rig up -----

Drilling and Remarks:

Tap 1. 2310

Pay 2335-23

100/65 lbs.

RECORD

Cased ----- in., ----- ft.

Sand -----

Gas -----

Oil -----

Total Depth -----

PRODUCTION

1st 24 hrs. Nat. -----

1st 24 hrs. after shot -----

Gas ----- Cu. Ft.

Dry Hole -----

Abandoned -----

Date

MAR 2 1923

191

M. A. BENEAR

Scout