


Map No. K Sec. 8 Twp. 22 R. 10

Well No. 1 Pixlee Farm  
Theta Oil Company

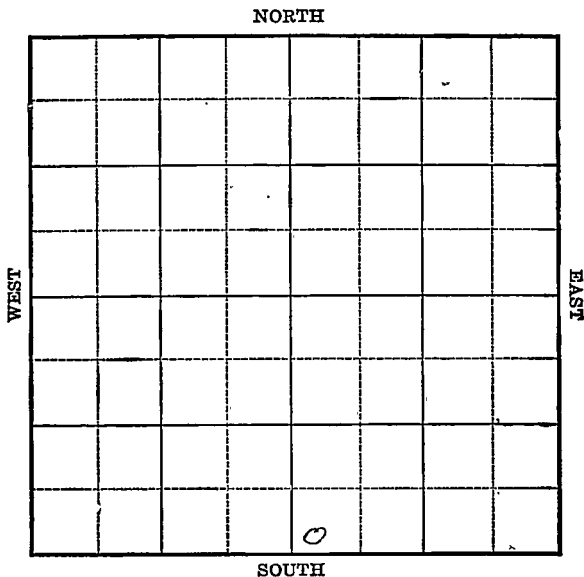

Location \_\_\_\_\_

Drilling Remarks:

\_\_\_\_\_

\_\_\_\_\_

**RECORD**

Cased \_\_\_\_\_ in. \_\_\_\_\_ ft.

Sand \_\_\_\_\_

Gas \_\_\_\_\_

Oil \_\_\_\_\_

Total Depth \_\_\_\_\_

Rig Up \_\_\_\_\_

Drilling Remarks:

\_\_\_\_\_

\_\_\_\_\_

\_\_\_\_\_

\_\_\_\_\_

\_\_\_\_\_

\_\_\_\_\_

\_\_\_\_\_

\_\_\_\_\_

\_\_\_\_\_

\_\_\_\_\_

**PRODUCTION**

1st 24 hrs. Nat. \_\_\_\_\_

1st 24 hrs. after shot \_\_\_\_\_

Gas \_\_\_\_\_ cu. ft.

Dry Hole \_\_\_\_\_

Abandoned \_\_\_\_\_



Map No. <sup>21</sup> ~~KANSAS~~ Sec. 8 Twp. 22 R. 10

Well No. 1 P. Miller

Tuta Oil Company

Contractor

**FIRST REPORT**

**SECTION PLAT**

----- Ft. from N. Line

200 Ft. from S. Line

----- Ft. from E. Line

200 Ft. from W. Line

		0	

Location -----

Rig up

Drilling and Remarks:

**RECORD**

Cased ----- in., ----- ft.

Sand -----

Gas -----

Oil -----

Total Depth -----

**PRODUCTION**

1st 24 hrs. Nat. -----

1st 24 hrs. after shot -----

Gas ----- Cu. Ft.

Dry Hole -----

Abandoned -----

Date

NOV 6 1924

M. A. BENEAR

192

Scout

21 **KANSAS** Sec. 7 Twp. 22 R. 10

Well No. 1 *Pixlee*

*Theta Oil* Company

Contractor

**COMPLETED**

**SECTION PLAT**

		0	

\_\_\_\_\_ Ft. from N. Line

*200* Ft. from S. Line

\_\_\_\_\_ Ft. from E. Line

*200* Ft. from W. Line

Location \_\_\_\_\_

Rig up \_\_\_\_\_

Drilling and Remarks:

*Sand 2310 - 2384*  
*T.D. 2384*  
*pumping 15 lbs*  
*Net*

**RECORD**

Cased \_\_\_\_\_ in., \_\_\_\_\_ ft.  
 Sand \_\_\_\_\_  
 Gas \_\_\_\_\_  
 Oil \_\_\_\_\_  
 Total Depth \_\_\_\_\_

**PRODUCTION**

1st 24 hrs. Nat. \_\_\_\_\_  
 1st 24 hrs. after shot \_\_\_\_\_  
 Gas \_\_\_\_\_ Cu. Ft.  
 Dry Hole \_\_\_\_\_  
 Abandoned \_\_\_\_\_

Date **DEC 11 1924**

**M. A. BENEAR**