


Map No. \_\_\_\_\_ Sec. 8 Twp. 22 R. 10

Well No. 2 Puffer Farm \_\_\_\_\_  
Waste Phillips Company \_\_\_\_\_

NORTH

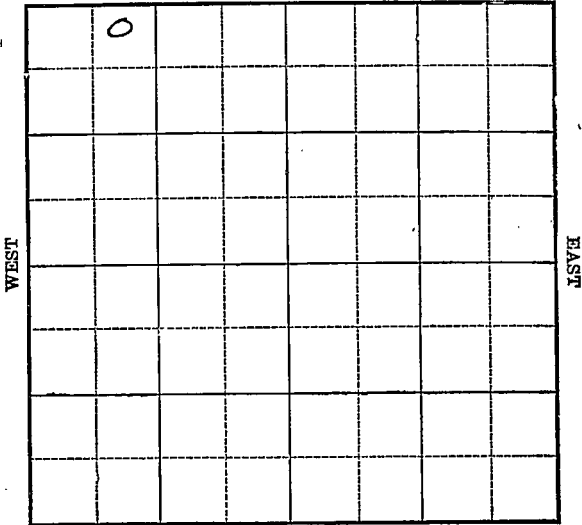

SOUTH

Location \_\_\_\_\_

Rig up \_\_\_\_\_

Drilling Remarks:

Drilling Remarks:

\_\_\_\_\_  
 \_\_\_\_\_  
RECORD

PRODUCTION

Cased \_\_\_\_\_ in. \_\_\_\_\_ ft.

1st 24 hrs Nat. \_\_\_\_\_

Sand \_\_\_\_\_

1st 24 hrs. after shot \_\_\_\_\_

Gas \_\_\_\_\_

Gas \_\_\_\_\_ cu. ft.

Oil \_\_\_\_\_

Dry Hole \_\_\_\_\_

Total Depth \_\_\_\_\_

Abandoned \_\_\_\_\_



Map No. **KANSAS** Sec. **8** Twp. **22** R. **10**

Well No. **2**  
*Walter Phillips* Company

Contractor

**FIRST REPORT**

**330** Ft. from N. Line

\_\_\_\_\_ Ft. from S. Line

\_\_\_\_\_ Ft. from E. Line

**980** Ft. from W. Line

**SECTION PLAT**

●			

Location \_\_\_\_\_

Rig up \_\_\_\_\_

Drilling and Remarks:

*Timber*

**RECORD**

Cased \_\_\_\_\_ in., \_\_\_\_\_ ft.

Sand \_\_\_\_\_

Gas \_\_\_\_\_

Oil \_\_\_\_\_

Total Depth \_\_\_\_\_

**PRODUCTION**

1st 24 hrs. Nat. \_\_\_\_\_

1st 24 hrs. after shot \_\_\_\_\_

Gas \_\_\_\_\_ Cu. Ft.

Dry Hole \_\_\_\_\_

Abandoned \_\_\_\_\_

Date

**MAR 22 1923**

192

**A. BENEAR**

Scout

Map No. **KANSAS** Sec. **8** Twp. **22** R. **10**

Well No. **2 Pikes**  
**Water Phillips** Company

**COMPLETED** Contractor

SECTION PLAT

**330** Ft. from N. Line

----- Ft. from S. Line

----- Ft. from E. Line

**980** Ft. from W. Line

0			

RECORD

Location -----

Rig up -----

Drilling and Remarks:

*Tap. pay*  
*2304-2339*  
*20/75 bbls*

Cased ----- in., ----- ft.

Sand -----

Gas -----

Oil -----

Total Depth -----

PRODUCTION

1st 24 hrs. Nat. -----

1st 24 hrs. after shot -----

Gas ----- Cu. Ft.

Dry Hole -----

Abandoned -----

Date

**MAY 19 1923**

**M. A. BENEAR**