


Kansas Greenwood Co
Map No. _____ Sec. *8* Twp. *22* R. *10*
Well No. *5 Puley* Farm _____
Theta oil Company _____

NORTH

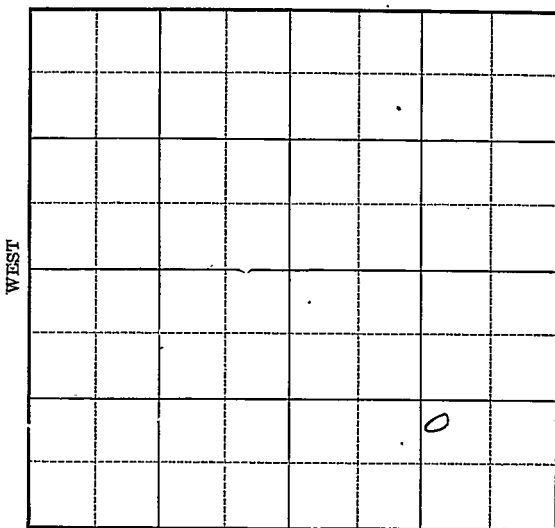

16

SOUTH

Location _____

Drilling Remarks _____

Rig Up _____

Drilling Remarks _____

RECORD

Cased _____ in. _____ ft.

Sand _____

Gas _____

Oil _____

Total Depth _____

PRODUCTION

1st 24 hrs. Nat. _____

1st 24 hrs. after shot _____

Gas _____ cu. ft.

Dry Hole _____

Abandoned _____

Greenwood

Map No. *Kansas* Sec. *8* Twp. *22 R 10*

Well No. *5 Ouley* Farm


Theta Oil Company

_____ Ft. from N. Line

990 Ft. from S. Line

990 Ft. from E. Line

_____ Ft. from W. Line

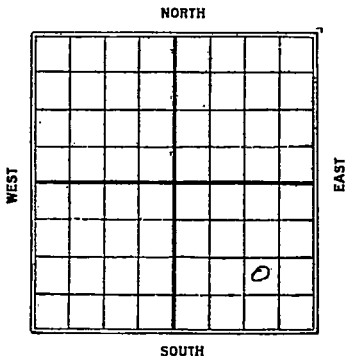

Date *1925*

REPORT

11/6 *Timbers*

11/13 *Rig*

11/19 *—*

11-27 *—*

12/3 *—*

12/10 *Delay 155°*

12/23 *Sand 2268-2336*

140 gts 90 Bbls

Menwood Co

Map No. *R21* KANSAS Sec. *8* Twp. *22* R. *10*

Well No. *5 Picky*

Hotz Oil Co Company

Contractor

FIRST REPORTS

_____ Ft. from N. Line

990 Ft. from S. Line

990 Ft. from E. Line

_____ Ft. from W. Line

SECTION PLAT

			o

Location _____

Rig up *Timbers*

Drilling and Remarks:

RECORD

Cased _____ in., _____ ft.

Sand _____

Gas _____

Oil _____

Total Depth _____

PRODUCTION

1st 24 hrs. Nat. _____

1st 24 hrs. after shot _____

Gas _____ Cu. Ft.

Dry Hole _____

Abandoned _____

Date

NOV 6 1925

CHAS. L. SHERWOOD

192

Scout

Sherwood Co

Map No. **KANSAS** Sec *21/8* Twp. *22* R. *10*

Well No. *5* *Rixley*
Shotwell *Oil Co* Company

Contractor

SECTION PLAT

			0

----- Ft. from N. Line
990
----- Ft. from S. Line
990
----- Ft. from E. Line
----- Ft. from W. Line

COMPLETED

Location -----
Rig up -----
Drilling and Remarks:

Oil 2285'
140/90 bhs.

RECORD

Cased _____ in., _____ ft.
Sand *2268-2336*
Gas -----
Oil -----
Total Depth *2336*

PRODUCTION

1st 24 hrs. Nat. -----
1st 24 hrs. after shot -----
Gas ----- Cu. Ft.
Dry Hole -----
Abandoned -----

Date
DEC 23 1925

192 **CHAS. L. SHERWOOD** Scout