

KANSAS


Greenwood ✓

Form 51-5M-4-36-Palace

Section 8 Township 22 Range 10-E

Well Number #7 Pixlee

Company Ohio

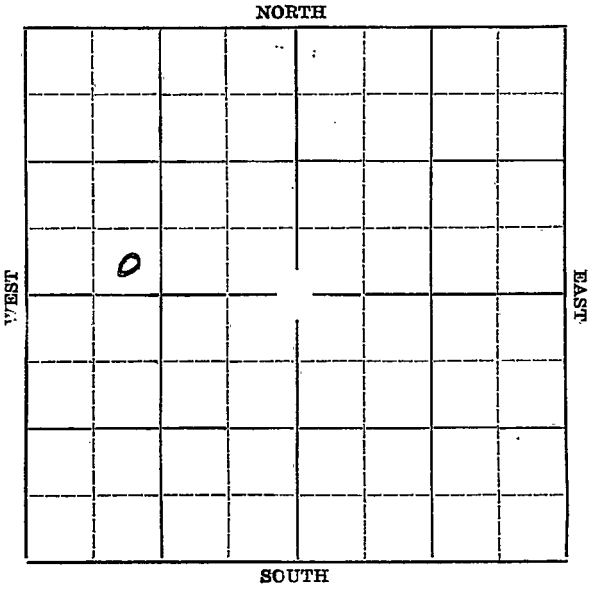

KANSAS

Sec. 8 Twp. 22 R. 10E

Well No. #7 Pixlee Farm


Ohio Company

 Ft. from N. Line

289' Ft. from S. Line

 Ft. from E. Line

789' Ft. from W. Line

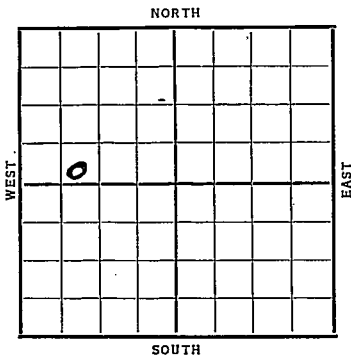

Date	REPORT
9/30	Rigging up.
10/8--	
10/15	Drlg. 600'.
10/22	Drlg. 975'.
10/29	Drlg. 1150'.
11/6	Drlg. 1485
11/12	No report.
11/19	No report.
11/27	Drlg. 2045'.
12/3	6" @ 2106'.
12/10	Drlg. 2370'.
12/17	Miss L. 2378'. T. D. 2451'.
	Clean out.
12/22	Miss. 2378'. T. D. 2477'.
	Water.
	ABANDONED

Greenwood

KANSAS

Map No. 21 Sec. 8 Twp. 22 R. 10E

Well No: 7 Pipes

Davis Company

Contractor

SECTION PLAT

0			

_____ Ft. from N. Line

289 Ft. from S. Line

_____ Ft. from E. Line

789 Ft. from W. Line

FIRST REPORT

Location _____

Rig up _____

Drilling and Remarks:

Rigging up.

RECORD

Cased _____ in., _____ ft.

Sand _____

Gas _____

Oil _____

Total Depth _____

PRODUCTION

1st 24 hrs. Nat. _____

1st 24 hrs. after shot _____

Gas _____ Cu. Ft.

Dry Hole _____

Abandoned _____

Date

SEP 30 1936 19

S. J. LEWIS

Scout

KANSAS

Map No. 21 Sec. 8 Twp. 22 R. 10EWell No. 7 PyleeOhio Oil Company

Contractor

SECTION PLAT

0			

15 Ft. from N. Line289 Ft. from S. Line

_____ Ft. from E. Line

787 Ft. from W. Line

ABANDONED

Location _____

Rig up _____

Drilling and Remarks:

Miss 2378WaterDYH

RECORD

Cased _____ in., _____ ft.

Sand _____

Gas _____

Oil _____

Total Depth 2477

PRODUCTION

- 1st 24 hrs. Nat. _____

1st 24 hrs. after shot _____

Gas _____ Cu. Ft.

Dry Hole _____

Abandoned _____

Date

DEC 22 1936

19

S. J. LEWIS

Scout