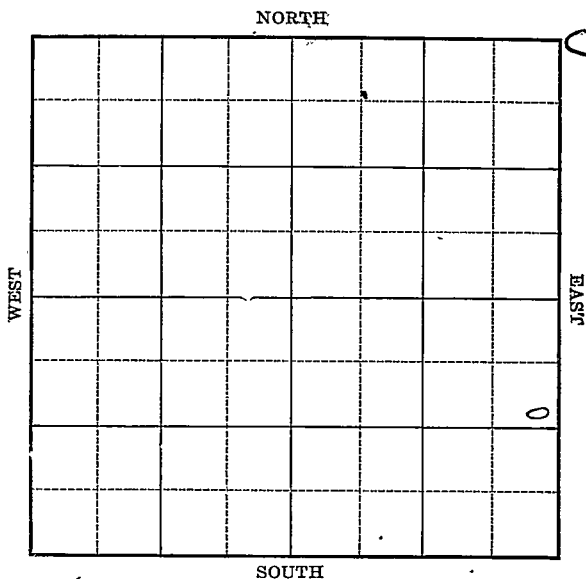


Map No. Kansas Sec. 8 Twp. 22 R. 10Well No. 7 Purley FarmTheta Oil Company

Location _____

Drilling Remarks _____

Rig Up _____

Drilling Remarks _____

RECORD

Cased _____ in. _____ ft.

Sand _____

Gas _____

Oil _____

Total Depth _____

PRODUCTION

1st 24 hrs. Nat. _____

1st 24 hrs. after shot _____

Gas _____ cu. ft.

Dry Hole _____

Abandoned _____

Map No. Kansas Greenwood Sec. 8 Twp. 22 R. 10
 Well No. 7 Pickle Farm
Theta Oil Company

NORTH

WEST

EAST

SOUTH

990 Ft. from N. Line

Ft. from S. Line

330 Ft. from E. Line

Ft. from W. Line

Date 1925

REPORT

12/23 Location12/31 _____19261/8 Rig1/4 _____1/30 Spndg 200'1/31 Dreg 2002/11 v 1400'2/16 v 1700'2/17 Dreg 2000'19262/24 Sand 2315-2354 80 gte
50 Bbls

Map No. KANSAS Sec. 8 Twp. 22 R. 10
 Well No. 7 Pixley
Hottel Oil Co Company

Contractor

SECTION PLAT

990 Ft. from N. Line

_____ Ft. from S. Line

330 Ft. from E. Line

_____ Ft. from W. Line

			6

FIRST REPORTS

Location ✓ _____

Rig up _____

Drilling and Remarks:

RECORD

Cased _____ in., _____ ft.

Sand _____

Gas _____

Oil _____

Total Depth _____

PRODUCTION

1st 24 hrs. Nat. _____

1st 24 hrs. after shot _____

Gas _____ Cu. Ft.

Dry Hole _____

Abandoned _____

Date

DEC 23 1925

192

CHAS. L. SHERWOOD

Scout

Sherwood Co

K21 KANSAS Sec. 8 Twp. 22 R. 10

Well No. 7 Fix by
Sherwood Co Company

Contractor

COMPLETED

SECTION PLAT

990 Ft. from N. Line

Ft. from S. Line

330 Ft. from E. Line

Ft. from W. Line

Location

Rig up

Drilling and Remarks:

Shipped Back

to 2349'

80950 lbs.

RECORD

Cased in. ft.

Sand 2215-2354

Gas

Oil

Total Depth 2354

PRODUCTION

1st 24 hrs. Nat.

1st 24 hrs. after shot

Gas Cu. Ft.

Dry Hole

Abandoned

Date

FEB 24 1926

192

CHAS. L. SHERWOOD

Scout