


*Greenwood*

Map No. *Kans.* Sec. *8* Twp. *22* R. *10*  
 Well No. *12* *Piplex* Farm  
*Theta Oil* Company

NORTH

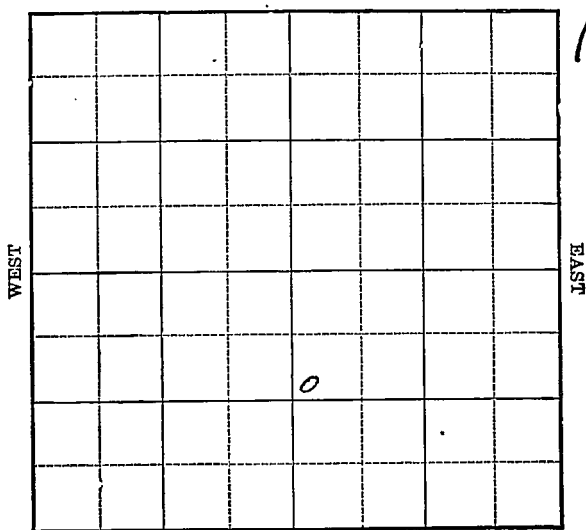

SOUTH

Location \_\_\_\_\_  
 Drilling Remarks \_\_\_\_\_

Rig Up \_\_\_\_\_  
 Drilling Remarks \_\_\_\_\_

## RECORD

Cased \_\_\_\_\_ in. \_\_\_\_\_ ft.  
 Sand \_\_\_\_\_  
 Gas \_\_\_\_\_  
 Oil \_\_\_\_\_  
 Total Depth \_\_\_\_\_


## PRODUCTION

1st 24 hrs. Nat. \_\_\_\_\_  
 1st 24 hrs. after shot \_\_\_\_\_  
 Gas \_\_\_\_\_ cu. ft.  
 Dry Hole \_\_\_\_\_  
 Abandoned \_\_\_\_\_

Map No. Kansas Sec. 8 Twp. 22 R. 10Well No. 12- Diller FarmTheta oil Company990 Ft. from N. Line

Ft. from S. Line

Ft. from E. Line

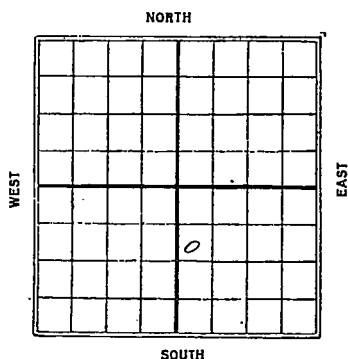330 Ft. from W. Line1926

Date

## REPORT

4/27 Bldg Rig  
 5/8 Rig  
 5/12 Spudding  
 5/19 Slg 400'  
 6/2 U. R. 1455-  
 6/10 Drlg 2040  
 6/17 Sand 2288-2365  
 160 gts 50 bbls

*Greenwood*  
 K21 KANSAS Sec. *8* Twp. *22* R. *10*  
 Map No. \_\_\_\_\_  
 Well No. *12* *Huber*  
*Meta Oil Co.* Company

Contractor \_\_\_\_\_

## SECTION PLAT

|  |  |   |  |
|--|--|---|--|
|  |  |   |  |
|  |  |   |  |
|  |  | o |  |
|  |  |   |  |

*990* Ft. from N. Line

\_\_\_\_\_ Ft. from S. Line

\_\_\_\_\_ Ft. from E. Line

*330* Ft. from W. Line

## FIRST REPORTS

Location \_\_\_\_\_

Rig up \_\_\_\_\_

Drilling and Remarks:

*Blow Rig*

## RECORD

Cased \_\_\_\_\_ in., \_\_\_\_\_ ft.

Sand \_\_\_\_\_

Gas \_\_\_\_\_

Oil \_\_\_\_\_

Total Depth \_\_\_\_\_

## PRODUCTION

1st 24 hrs. Nat. \_\_\_\_\_

1st 24 hrs. after shot \_\_\_\_\_

Gas \_\_\_\_\_ Cu. Ft.

Dry Hole \_\_\_\_\_

Abandoned \_\_\_\_\_

Date

APR 28 1926

CHAS. L. SHERWOOD  
 \_\_\_\_\_ 192 \_\_\_\_\_ Scout

*Sherwood*  
 121 KANSAS Sec. 8 Twp. 22 R. 10  
 Map No. 12 Fix 62  
 Well No. 26 kg OD Co  
 Company

Contractor

## COMPLETED

## SECTION PLAT

990 Ft. from N. Line

Ft. from S. Line

Ft. from E. Line

330 Ft. from W. Line

|  |  |   |  |
|--|--|---|--|
|  |  |   |  |
|  |  |   |  |
|  |  | 0 |  |
|  |  |   |  |

Location

Rig up

Drilling and Remarks:

1607/50 BS.

## RECORD

Cased in, ft.

Sand 2288-2365

Gas

Oil

Total Depth 2365

## PRODUCTION

1st 24 hrs. Nat.

1st 24 hrs. after shot

Gas Cu. Ft.

Dry Hole

Abandoned

Date

JUN 17 1926

CHAS. L. SHERWOOD

192

Scout