

Map No. **KANSAS** Sec. **8** Twp. **22** R. **10-E**Well No. **17-Pixlee** Farm**Barbara Oil** Company

NORTH

WEST

EAST

SOUTH

Location

Drilling Remarks

Rig Up

Drilling Remarks

RECORD

Cased _____ in. _____ ft.

Sand _____

Gas _____

Oil _____

Total Depth _____

PRODUCTION

1st 24 hrs. Nat. _____

1st 24 hrs. after shot _____

Gas _____ cu. ft. _____

Dry Hole _____

Abandoned _____

Greenwood

Map No. **KANSAS**

Sec. **8**

Twp. **22**

R. **10E**

Well No. **17- Piflee**

Farm

Barbara Oil

Company

300


Ft. from N. Line

Ft. from S. Line

Ft. from E. Line

800

Ft. from W. Line

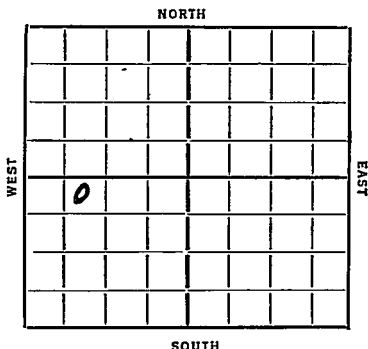

REPORT

Date	
3/18	Machine
3/20	--
3/27	--
4/2	Rign.
4/10	-- 4/16--
4/23	Drlg. 1385'
4/30	Drlg. 1650'.
5/7	Drlg. 2150'.
5/14	Bart. sd. 2320' Drlg.
5/21	Testing.
5/28	Miss. Lime. 2393'. T.D. 2518'. 1800 feet oil. acidizing.
6/5	--
6/10/36	Miss. lime-2393'.
	T.D. 2518'.
	40 bbls oil.
	COMPLETED

Map No. 21 Sec. 8 Twp. 22 R. 10EWell No. 17- RipleeBarbara oil Company

Contractor

FIRST REPORT

SECTION PLAT

300 Ft. from N. Line

Ft. from S. Line

Ft. from E. Line

800 Ft. from W. Line

0			

Location

Rig up

Drilling and Remarks:

Machine

RECORD

Cased _____ in., _____ ft.

Sand _____

Gas _____

Oil _____

Total Depth _____

PRODUCTION

1st 24 hrs. Nat. _____

1st 24 hrs. after shot _____

Gas _____ Cu. Ft.

Dry Hole _____

Abandoned _____

Date

3-18-36 192

ORVAL MANNSCHRECK

Scout

Map No. 21 KANSAS Sec. 8 Twp. 22 R. 10EWell No. 17 PiffleBarbara Oil Company

Contractor

SECTION PLAT

0			

300 Ft. from N. Line

_____ Ft. from S. Line

_____ Ft. from E. Line

500 Ft. from W. Line

COMPLETED

Location _____

Rig up _____

Drilling and Remarks:

Miss L - 239840 88 1/2

RECORD

Cased _____ in., _____ ft.

Sand _____

Gas _____

Oil _____

Total Depth 251 8

PRODUCTION

1st 24 hrs. Nat. _____

1st 24 hrs. after shot _____

Gas _____ Cu. Ft.

Dry Hole _____

Abandoned _____

Date

JUN 10 1936 19

S. J. LEWIS

Scout