


Section 8 Township 22 Range 10E

Well No. #31 Pixlee

Company Pickrell Drlg.

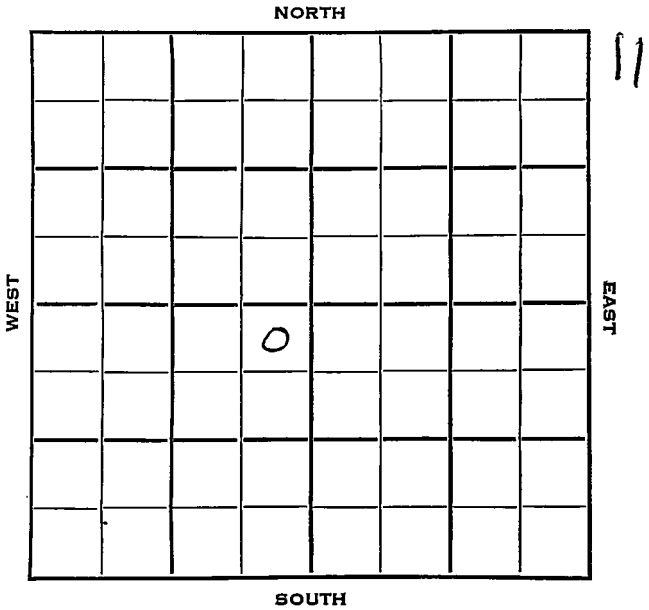

Sec. 8 Twp. 22 R. 10 E

Well No. # 31 Pixlee Farm

Pickrell Drlg. Company


Contractor

330 Ft. from N. Line

\_\_\_\_\_ Ft. from S. Line

330 Ft. from E. Line

\_\_\_\_\_ Ft. from W. Line

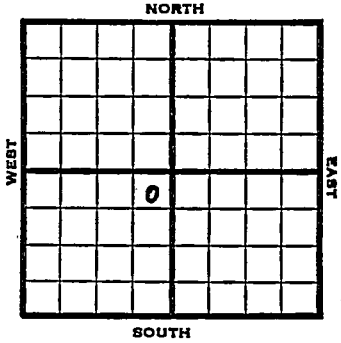

NE NE SW

1953

Elev. -

REPORT

8/19 8" @ 68 KC 1653'  
Drlg. 1793'

8/26 D&A  
TD 2476  
8" @ 68  
KC 1653, Bart 2315, Miss 2421,  
TD 2476  
D&A

ABANDONED



