


36-22-9E

10'
30" 8 1-4
15 1-2 6 5-8
12 1-2 5 3-16

FARM W. L. Hartley
COMPANY Waite Phillips Co.
CONTRACTOR
COMMENCED

NO. 1 COUNTY Chase

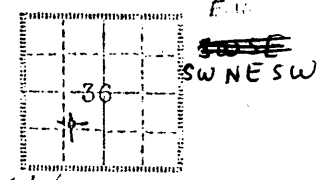

TOTAL DEPTH 2540

SHOT QUARTS BETWEEN

COMPLETED 9/7/25

CORRESPONDENCE REGARDING THIS WELL SHOULD BE REFERRED TO Waite Phillips Co.
Tulsa, Okla.

ELEVATION 1566

INITIAL PRODUCTION dry

FIGURES INDICATE BOTTOM OF FORMATIONS.
REMARKS

Formation	Depth	Formation	Depth.
lime	19	lime	1000
shale	35	lime	1020
red rock	50	slate	1040
slate	65	lime	1060
lime	75	slate	1080
shale	90	lime	1100
lime	105	slate	1120
shale	120	lime	1135
lime	125	lime	1160
shale	150	slate	1170
slate	170	lime	1180
lime	190	slate	1205
slate	196	slate	1245
shale	202	lime	1290
lime	207	slate	1415
slate	225	shale	1520
lime	230	water sand	1535
slate	262	water sand	1570
slate	275	slate	1580
lime	300	shale	1593
shale	310	shale	1625
slate	320	lime	1645
lime	325	lime	1700
shale	340	lime	1755
slate	345	shale	1795
lime	350	slate	1820
slate	365	lime	1925
shale	400	lime	2025
shale	425	lime	2070
lime	440	slate	2145
shale	465	slate	2190
shale	495	slate	2200
water sand	545	lime	2220
sand	575	shale	2250
slate	600	shale and lime	2330
slate	615	shale	2400
slate	625	shale	2500
lime	630	sandy shale	2513
slate	675	sandy shale	2532
lime	680	water sand	2540
slate	700		
shale	720		
slate	722		
slate	730		
lime	740		
shale	770		
lime	830		
lime	840		
shale	855		
lime	900		
slate	960		

T. D.