


Map No. _____ Sec. 9 Twp. 22 R. 4
 Well No. 9 Jolliffe Farm _____
Watkinson et al Company

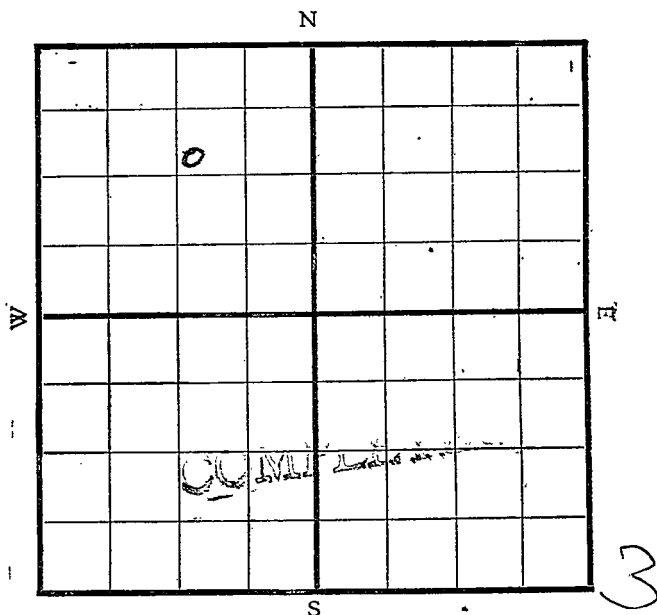

Location _____

Drilling Remarks:

Rig Up _____

Drilling Remarks:

RECORD

Cased _____ in. _____ ft.

Sand _____

Gas _____

Oil _____

Total Depth _____

PRODUCTION

1st 24 hrs. Nat. _____


1st 24 hrs. after shot _____

Gas _____ cu. ft.

Dry Hole _____

Abandoned _____

_____Ft. from W. Line

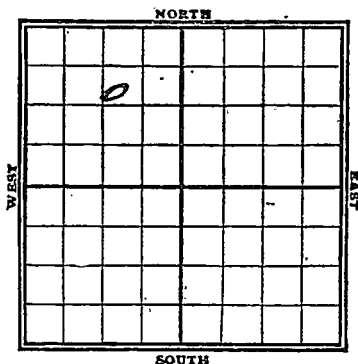

Date	REPORT
6/15	Rig up
22	Shut
28	525
7/7	950
12	1200
19	1710
26	Shut @ 2040'
8/2	2335
8/9	Sand 2460-63 (H.F. oil)
8/16	2460-63-250 bbl.

Map No. K 23 Sec. 9 Twp. 22 R. 4Well No. 9 JoliffHatchorn et al Company

Contractor

SECTION PLAT

1120 Ft. from N. Line

Ft. from S. Line

1120 Ft. from E. Line

Ft. from W. Line

	0		

FIRST REPORT

Location

Rig up ☒

Drilling and Remarks:

RECORD

Cased _____ in., _____ ft.

Sand _____

Gas _____

Oil _____

Total Depth _____

PRODUCTION

1st 24 hrs. Nat. _____

1st 24 hrs. after shot _____

Gas _____ Cu. Ft.

Dry Hole _____

Abandoned _____

Date

6/15 1920

Pyle

Scout

Map No. K 23 Sec. 9 Twp. 22 R. 4Well No. 9 Lalliffe
Hatchorn et al Company

Contractor

SECTION PLAT

1120 Ft. from N. Line

Ft. from S. Line

1120 Ft. from E. Line

Ft. from W. Line

	0		

COMPLETED

Location

Rig up

Drilling and Remarks:

RECORD

Cased _____ in., _____ ft.

Sand 2460 - 6.3

Gas _____

Oil _____

Total Depth _____

PRODUCTION

1st 24 hrs. Nat. 250 bbls

1st 24 hrs. after shot _____

Gas _____ Cu. Ft.

Dry Hole _____

Abandoned _____

Date

8/16 1920

Pyle

Scout