

Map No. **KANSAS** Sec. 9 Twp. 22 R. 8 42Well No. 9-Jollye Farm
Orlando Company

NORTH

WEST

					0		1

EAST

SOUTH

Location.....

Drilling Remarks

Rig Up.....

Drilling Remarks

RECORD

Cased.....in.....ft.

Sand.....

Gas.....

Oil.....

Total Depth.....

PRODUCTION

1st 24 hrs. Nat.....

1st 24 hrs. after shot.....

Gas.....cu. ft.....

Dry Hole.....

Abandoned.....

Map No. Sec. Twp. R.

Well No. Farm


..... Company

..... Ft. from N. Line

..... Ft. from S. Line

..... Ft. from E. Line

..... Ft. from W. Line

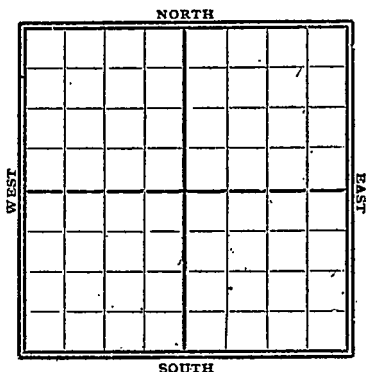

1922

Date

REPORT

Gypsy Record

6/6

Abd 710 2570

MAP No. _____ SEC. 9 TWP. 27S R. 4E
 WELL No. 4 Callie
Orlando COMPANY

CONTRACTOR

SECTION PLAT

		0	

_____ FT. FROM N. LINE

_____ FT. FROM S. LINE

_____ FT. FROM E. LINE

_____ FT. FROM W. LINE

LOCATION _____

RIG UP _____

DRILLING AND REMARKS:

2555

RECORD

CASED _____ IN. _____ FT.

SAND _____

GAS _____

OIL _____

TOTAL DEPTH. 7570

PRODUCTION

1ST 24 HRS. NAT. _____

1ST 24 HRS. AFTER SHOT _____

GAS _____ CU. FT.

DRY HOLE ✓ABANDONED ✓

DATE

6/6192

SCOUT